

RECEIVED


MAY 13 1975

STATE ENGINEER
SALEM, OREGON

Application No. 53123

Permit No. 38601

T. 9S. R. 26 & 27E. W.M.

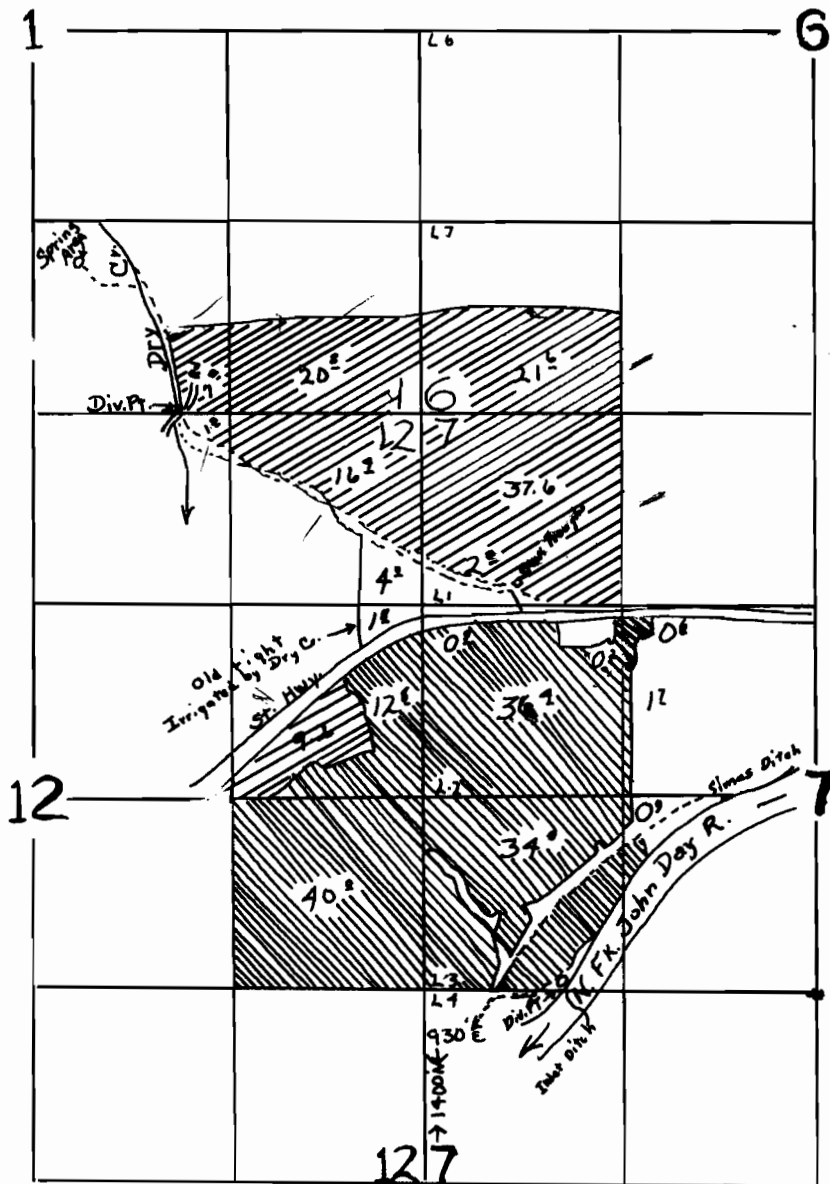

/// New Right

/// old Right