


T27S

R4W

SEC. 31

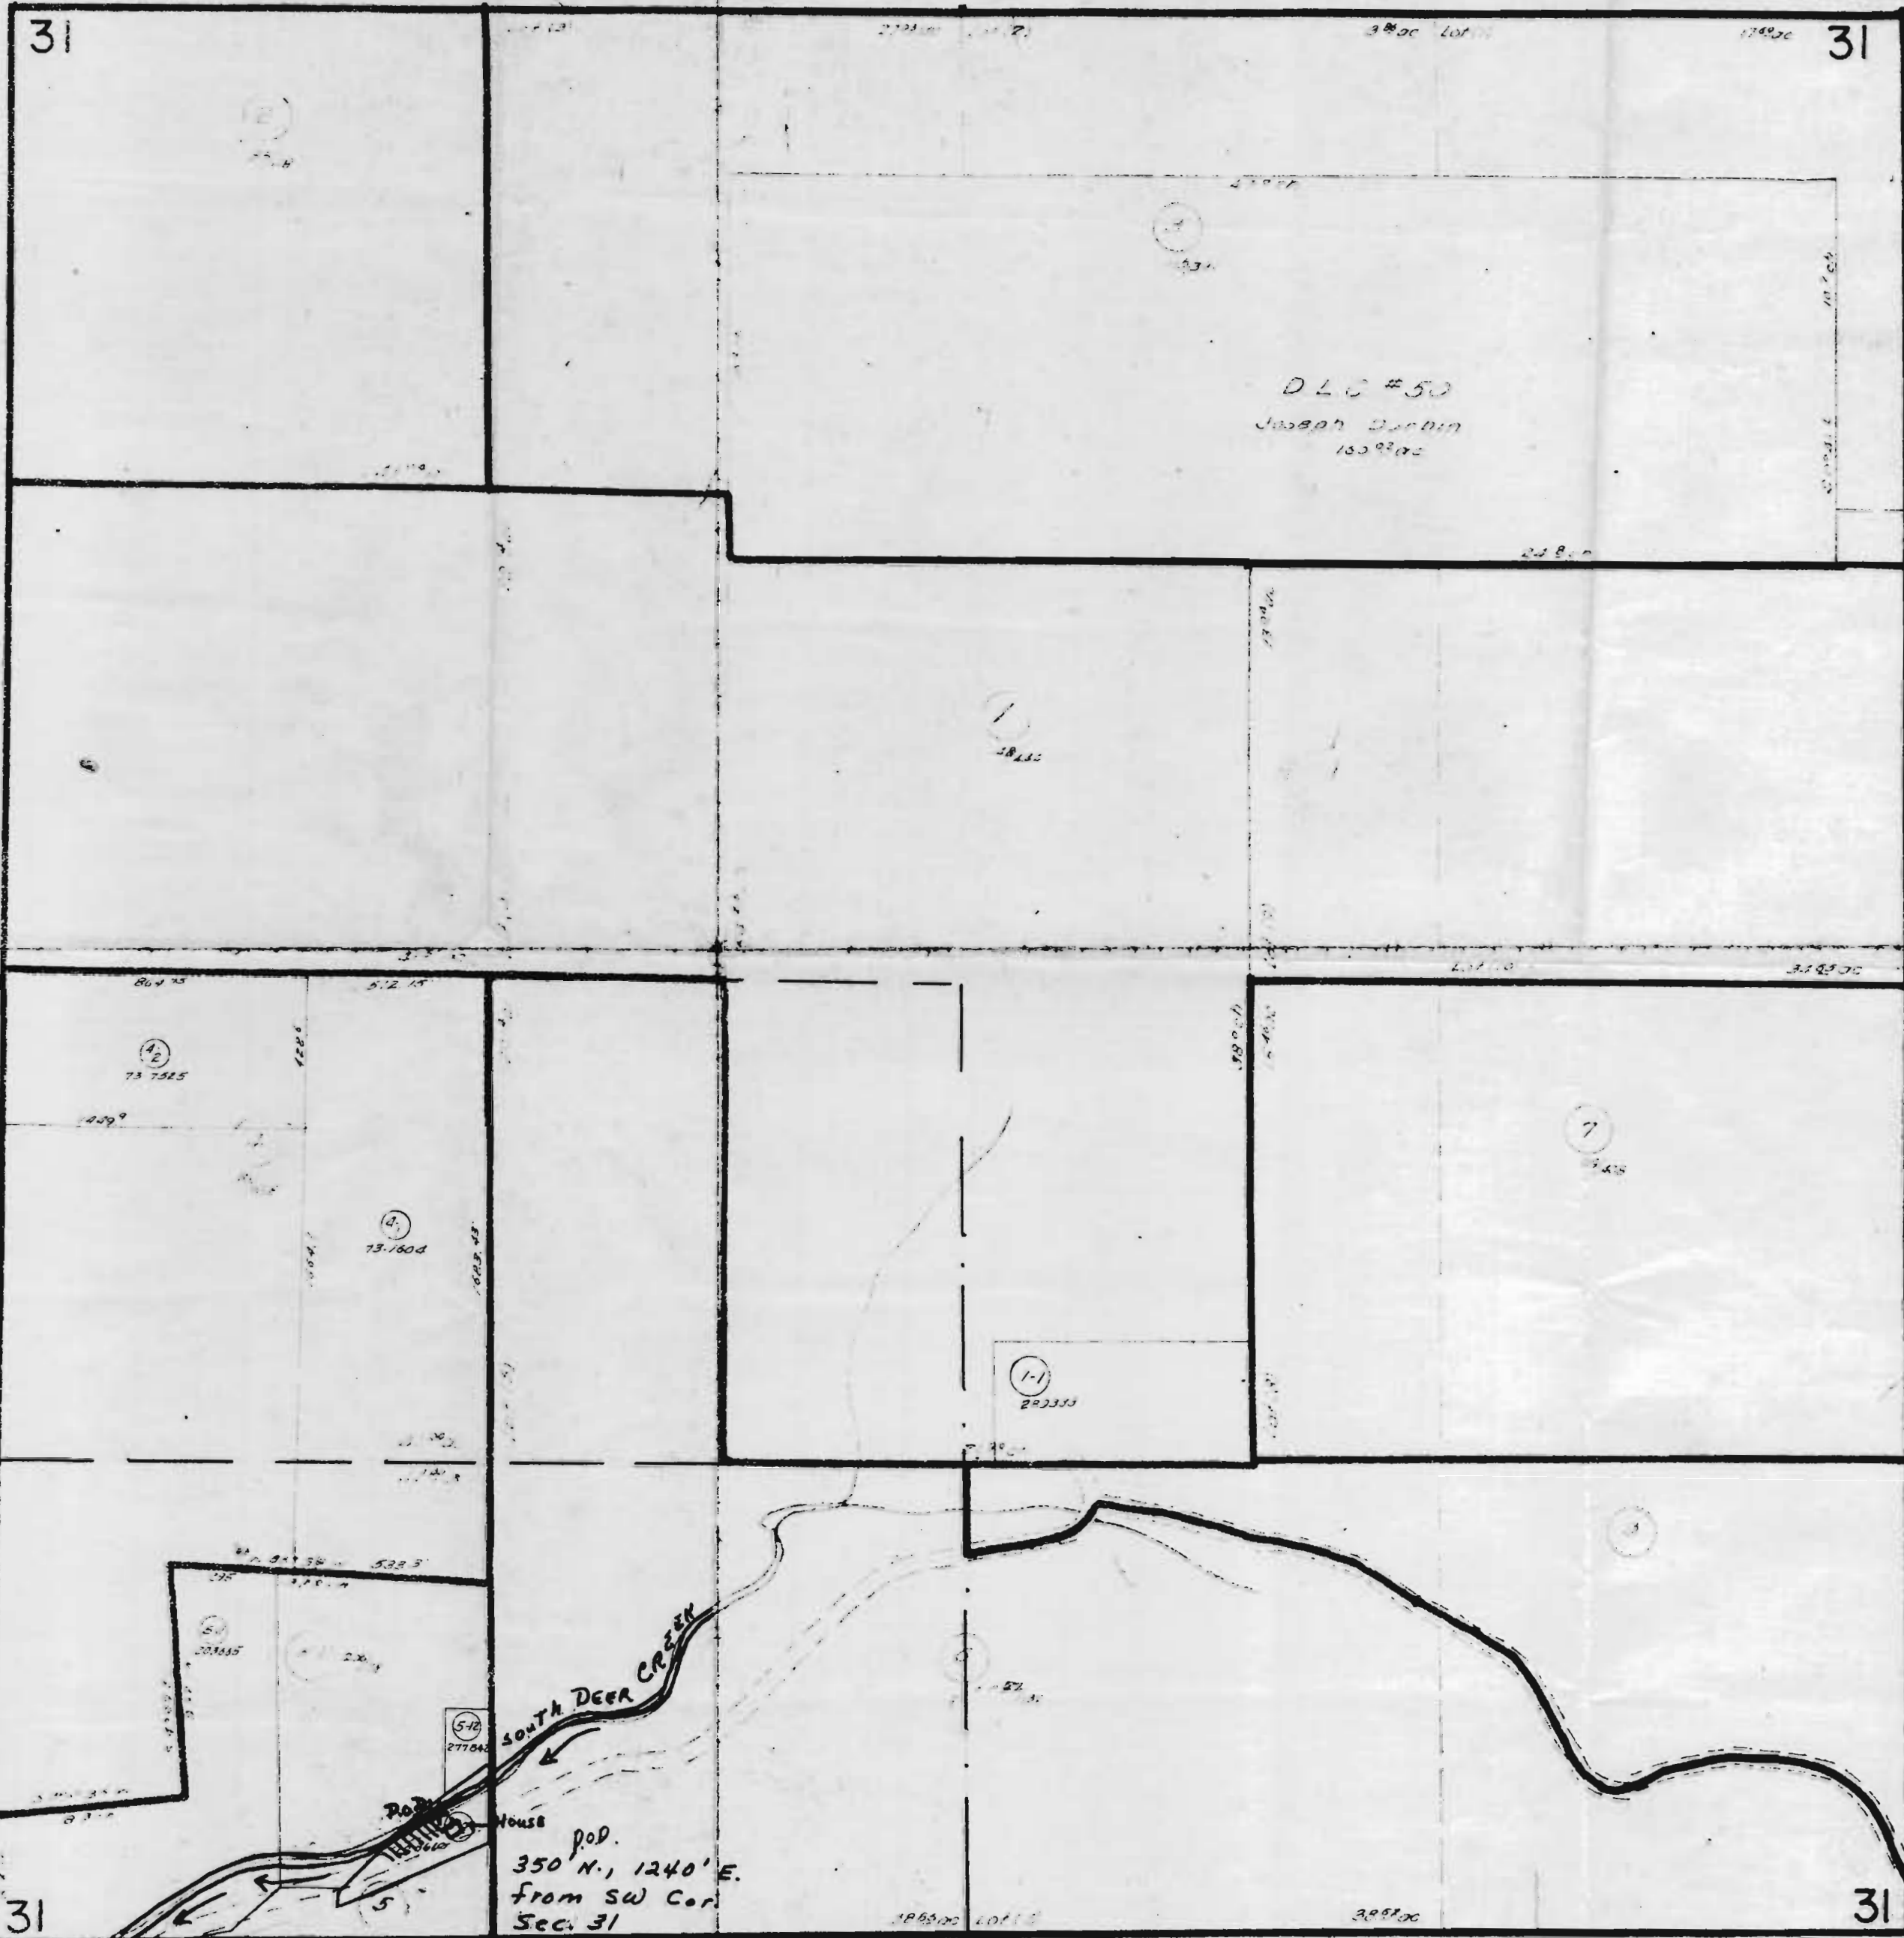

T.27S, R4W
 SEC. 31
 Douglas County
 OREGON

RECEIVED
 AUG 22 1973
 STATE ENGINEER
 SALEM, OREGON

Application No. 51126
 Permit No. 38616

SCALE 1" = 400'