

RECEIVED

MAR 11 1974
STATE ENGINEER
SALEM, OREGON

RECEIVED


JAN 14 1974
STATE ENGINEER
SALEM, OREGON

RECEIVED

DEC 19 1973
STATE ENGINEER
SALEM, OREGON

RECEIVED

SEP 5 1973
STATE ENGINEER
SALEM, OREGON

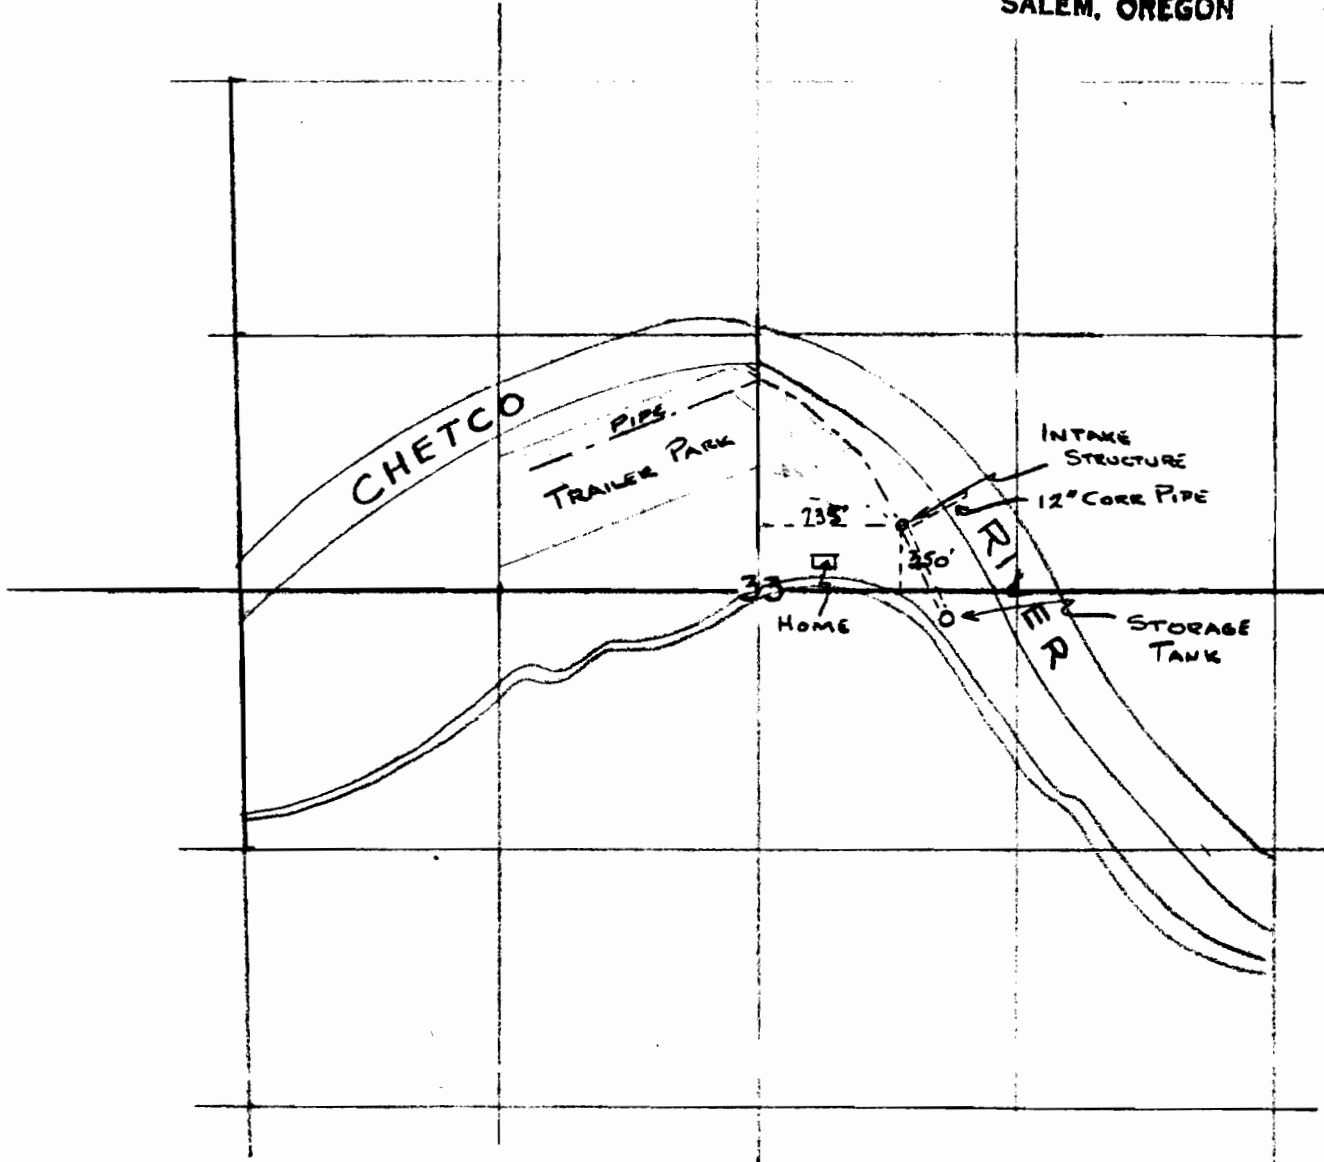

SEC 33, T40S, R13W, W.M.

RECEIVED

JUN 10 1974
STATE ENGINEER
SALEM, OREGON

RECEIVED

MAY 20 1974
STATE ENGINEER
SALEM, OREGON

Application No. 51190
Permit No. 38682

WATER APPLICATION
ON
CHETCO RIVER

SCALE 1" = 100'