

SEE MAP 36 5 29

30 29


1/4 COR.

31 32 100
80.00 Ac.

* N 89° 45' W C.S. 56-60

Southard Pond

FRAN-DON SUB.

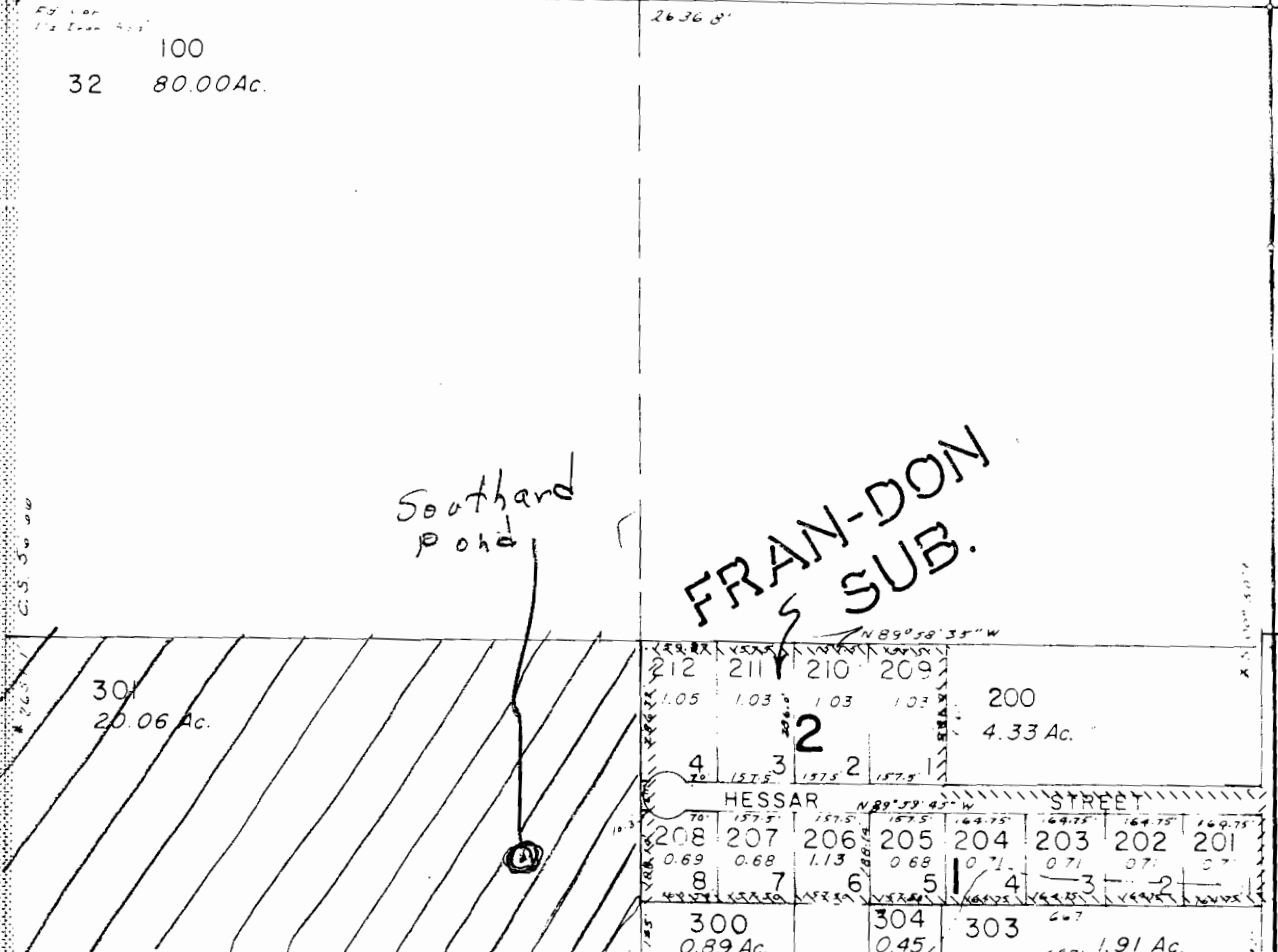

500
34.82 Ac.

400
2.06 Ac.

401
1.00 Ac.

402
1.00 Ac.

600
4.89 Ac.

800
30.38 Ac.

900
7.84 Ac.

702
12.71 Ac.

C.S. 101-71

700
16.50 Ac.

S 89° 41' W

5

100
0.6

11
9

12
5

13
2

SEE MAP 36 5 31

1/4 COR.

5 82-66

1/4 COR.





