


S.16.T.35.S.R.4 W

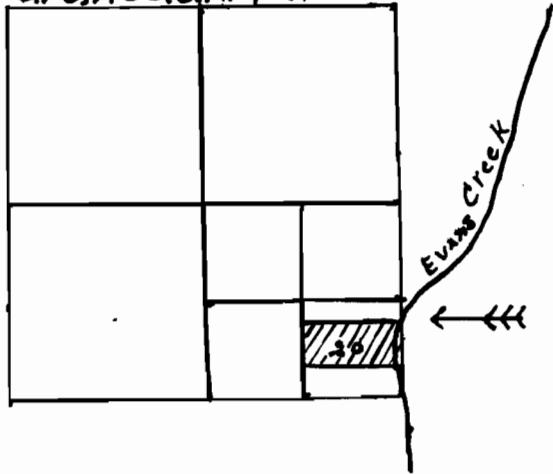

→→→ Indicates location of pump

MAY

5773  
3875