T.2&3 N, R. 9 W.W.M

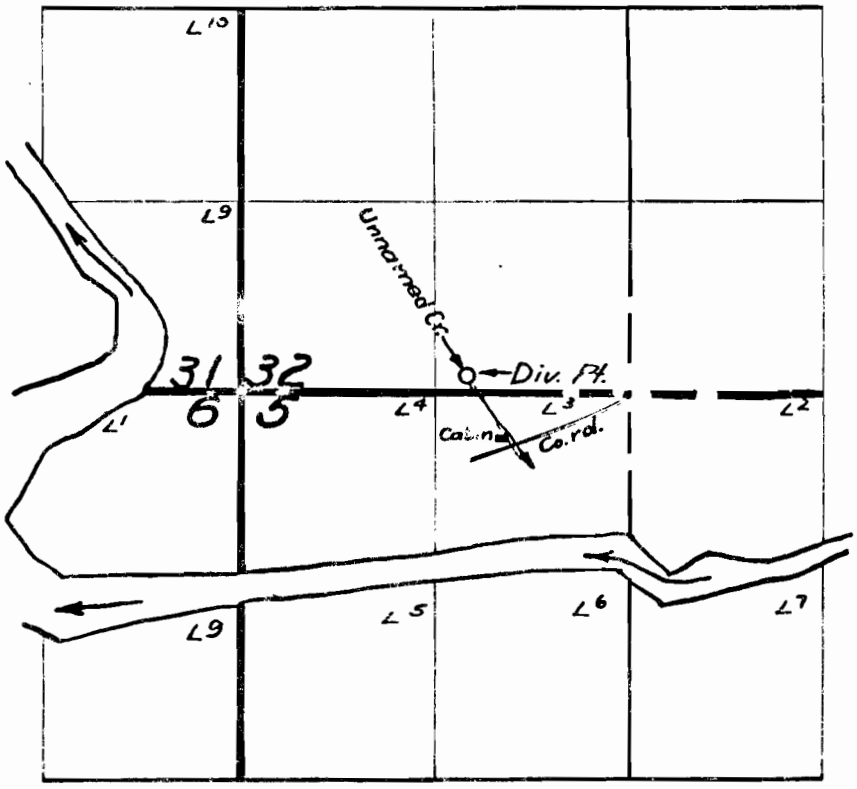

Diversion Point Located: 120 feet North & 1100 feet West from the N¼ corner of Section 5

Application No. 51344
Permit No. 38761

RECEIVED
APR 24 1974
STATE ENGINEER
SALEM, OREGON

FINAL PROOF SURVEY

UNDER

Application No. 21179 Permit No. 16598

IN NAME OF

Kenneth A. Crowell

Surveyed Sept. 21 1955, by M. Bish

1955 N