


T.34S., R.6W., W.M.

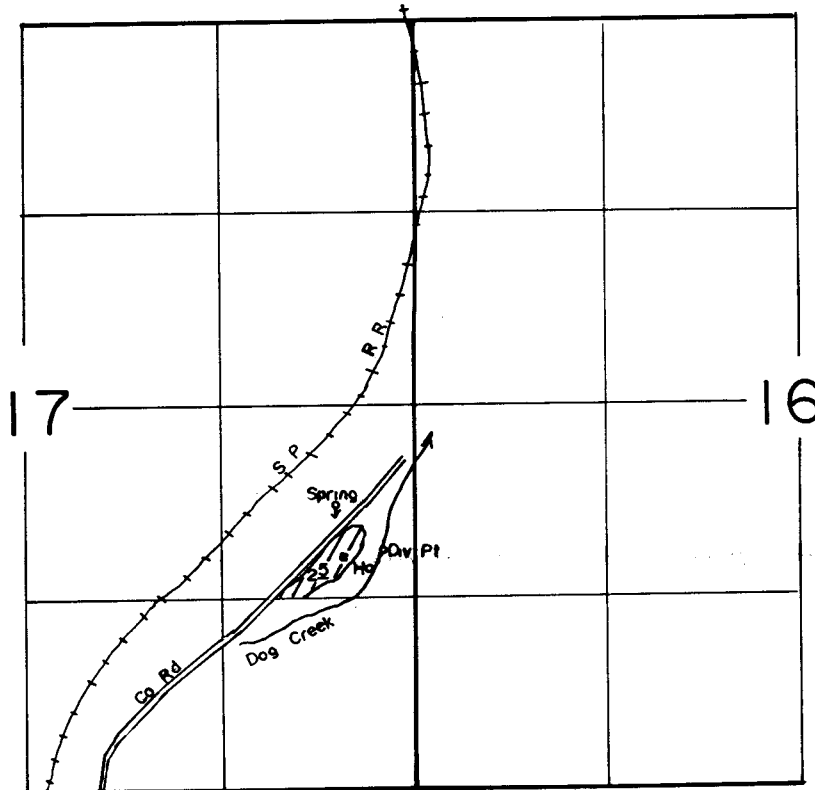

Spring Loc 650' N & 550' W, Div Pt Loc 330' N & 220' W Both From The NE Corner Of SE 1/4 SE 1/4 Section 17

SCALE: 1" = 1320'

FINAL PROOF SURVEY
UNDER

RECEIVED
MAR 6 1991

WM. DIST. 14
GRANTS PASS, ORE.

Application No. 51363..... Permit No. 38844.....
IN NAME OF

.....CLIFFORD..... HENROTIN.....

Surveyed MAY...17... 1989., by B.S. JAMES.....