

T.39S., R.7W., W.M.


SEC. 19

NW 1/4 NE 1/4

RECEIVED

MAY 20 1985

WPA DIST. 24
OPENTS AREA 2082

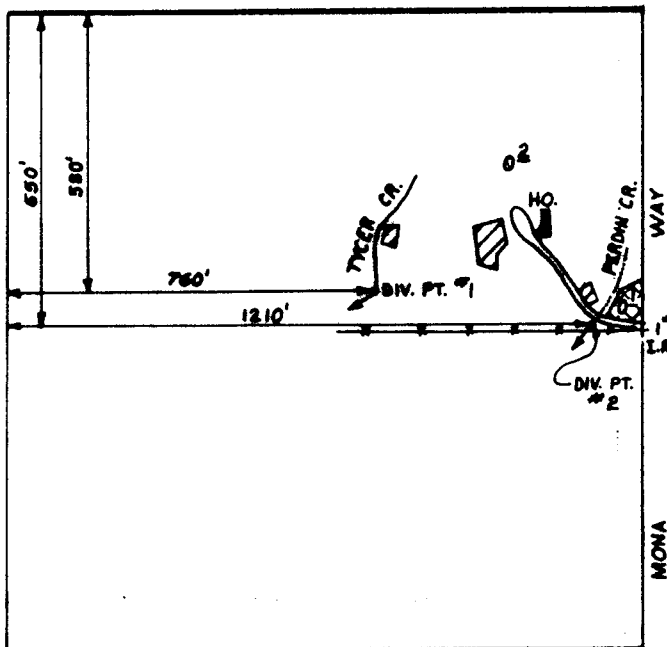

SCALE: 1" = 400'

IRRIGATED from TYCER CR.

IRRIGATED from PERDIN CR.

FINAL PROOF SURVEY UNDER

Application No. 51514 Permit No. 38877....
IN NAME OF

.....JERRY WAYNE JENSON.....

Surveyed AUG. 25. 19.82, by BRUCE R. SUND.

PTS-1982-14A TWB