


T.9S.R.5W.W.M.

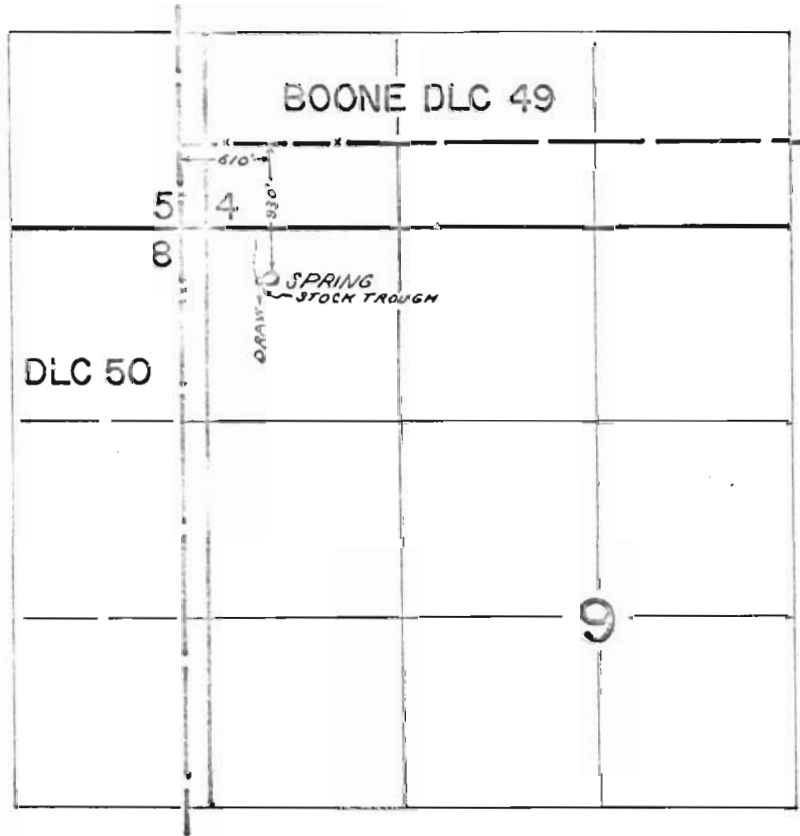


Application No. 51581  
Permit No. 38908

Application No. \_\_\_\_\_ Permit No. \_\_\_\_\_  
IN NAME OF

CLARE R. & NOLA R. MILLHOUSER

Surveyed November 2, 1970, by Donald R. Buehl

# T.9S.R.5W.W.M.

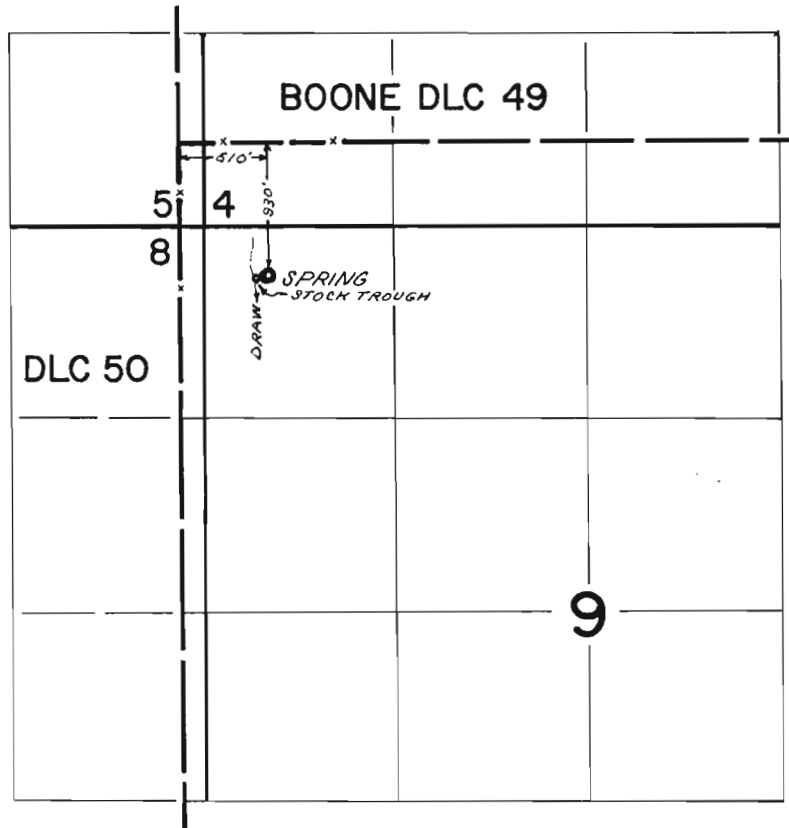

Application No. 51581 Permit No. \_\_\_\_\_  
IN NAME OF

**CLARE R. & NOLA R. MILLHOUSER**

Surveyed November 2, 1970, by Donald R. Buell