


RECEIVED

JAN 31 1974

STATE ENGINEER  
SALEM, OREGON

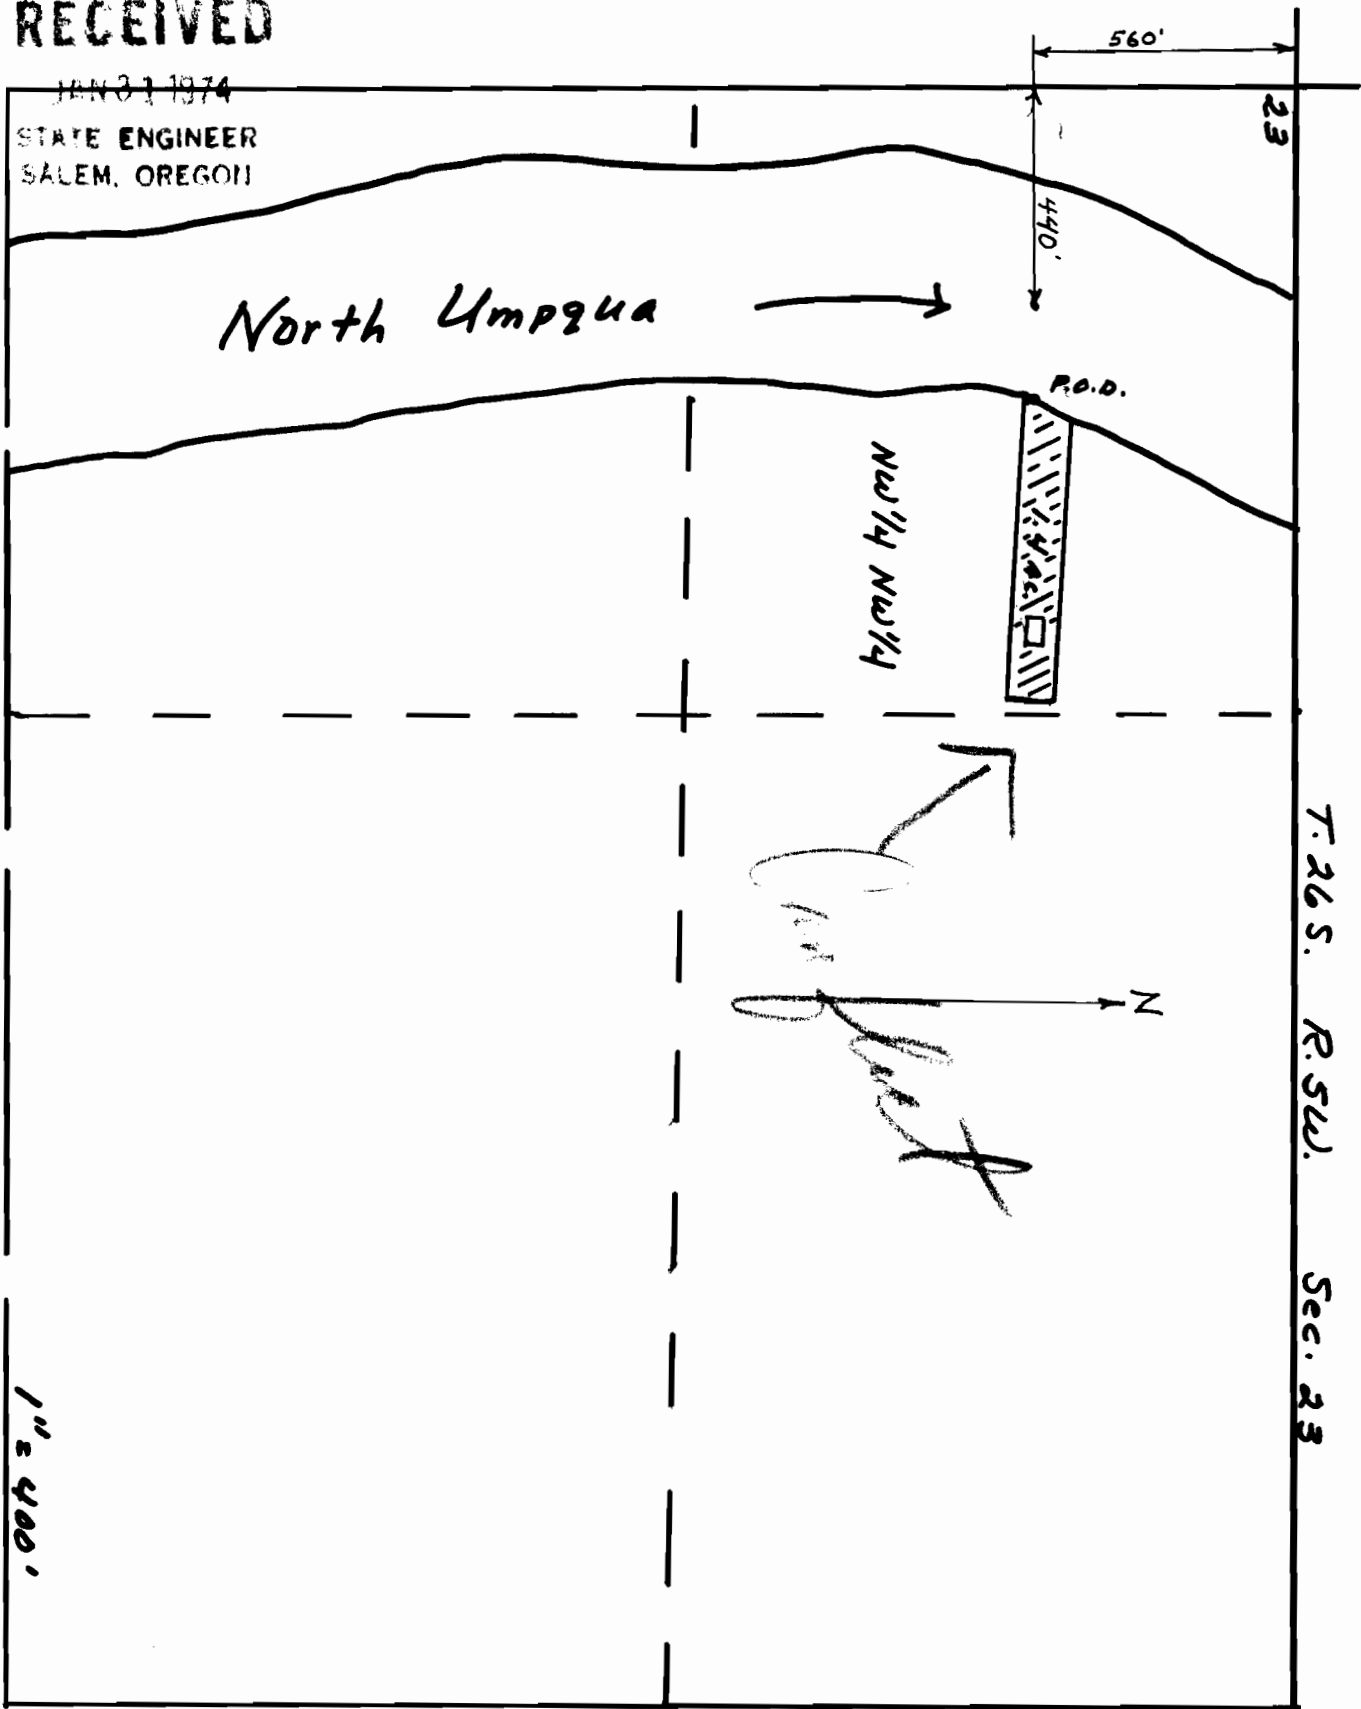

Application No. 51032

Permit No. ~~38932~~

38937