


39031

T.36 S., R.5 W., W.M.

RECEIVED

OCT 8 1980

WM. DIST. 14
GRANTS PASS, ORE

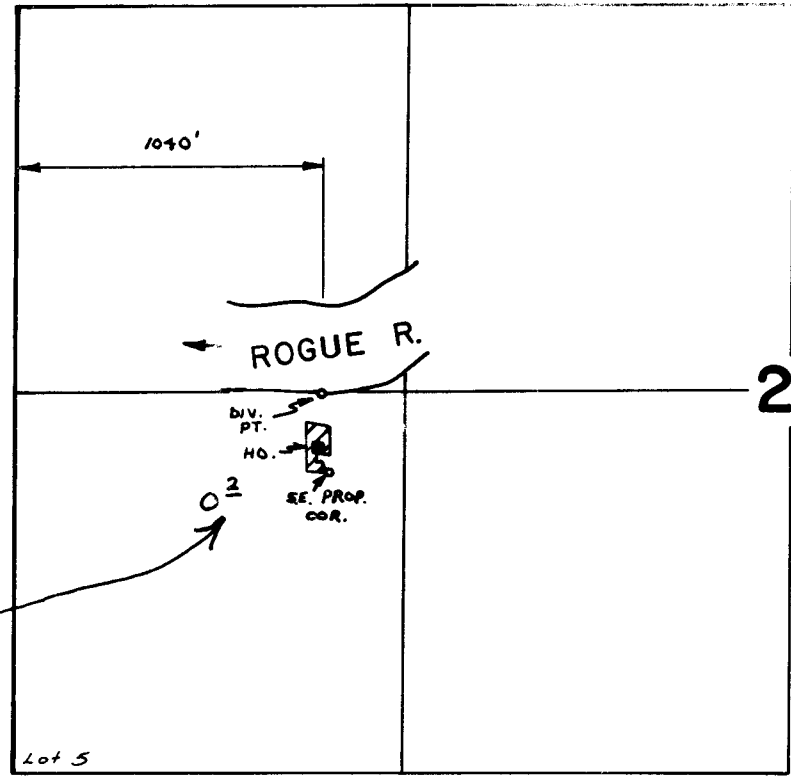

THIS SHOULD
 Be O³
 as per Joe Mouton
 SWRD 2/26/92

SCALE: 1" = 660 FT.
 8" = 1 mi

FINAL PROOF SURVEY
 UNDER

Cont - 49544

Application No. 51833 Permit No. 39031
 IN NAME OF

OSWALD STAUTZ

Surveyed SEPT. 20 1977, by B. SUND

D.H.M.
 P.T.S. - 1977 - 14 - B