


SEC. 19, T.13 S., R.2 E., W.M., LINN CO., ORE.  
Scale: 1" = 10 Chains

RECEIVED  
MAY 23 1974  
STATE ENGINEER  
SALEM, OREGON

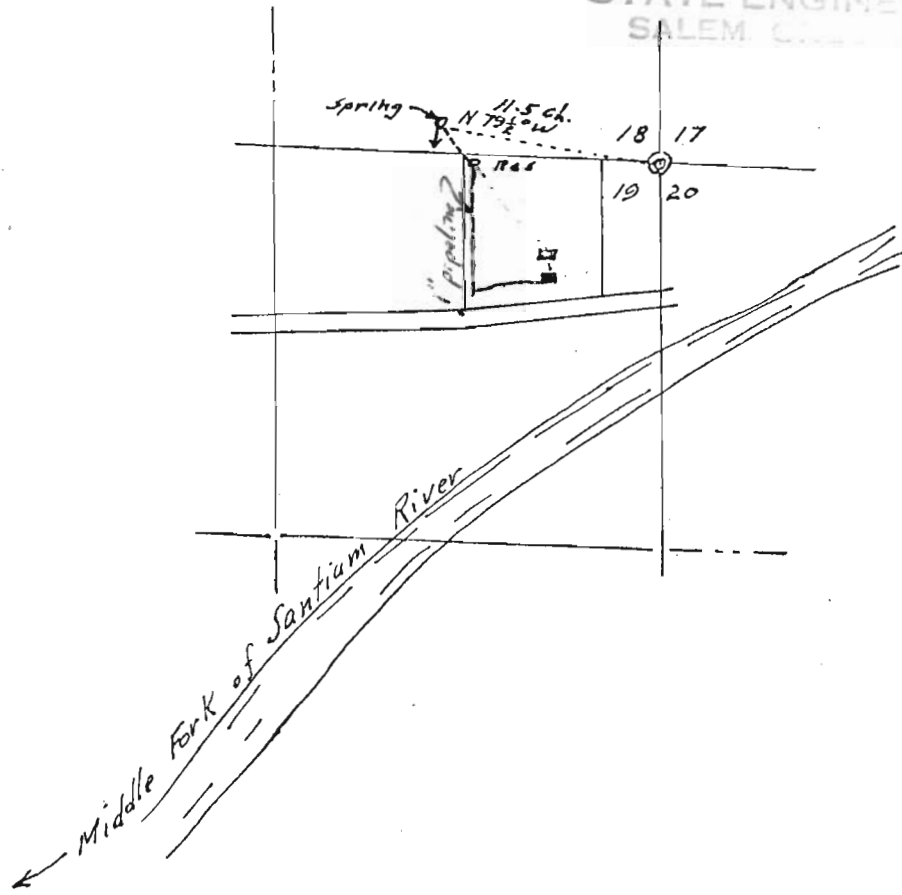

Application No. ~~4718~~ 51986  
Permit No. ~~30531~~ 39092