


T. 33 S., R. 6 W., W.M.

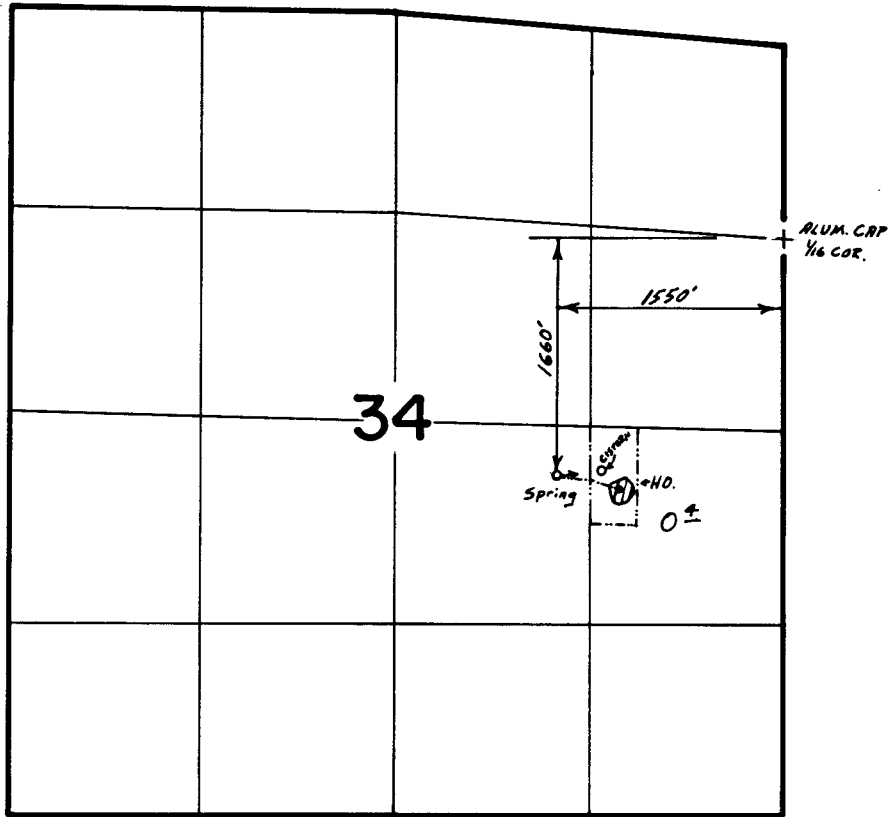

Scale 4" = 1 Mile

RECEIVED

JUN 17 1987

WM. DIST. 14  
GRANTS PASS, ORE.

**FINAL PROOF SURVEY**  
UNDER

Application No. 51775 Permit No. 39136  
IN NAME OF

HERMES RAINBOW... SOLOMON... &... KATHLEEN SMITH HARRY

Surveyed Sept. 12, 1984, by J.R. WOODROOF  
" Feb 14 1985 BS James

41033-179-154R

*By*