


Permit: S 39267
Volume: 5
Strm: JUMPOFF JOE CR
Trib: ROGUE R
Priority: 7/01/74

T.35 S., R.5 W., W.M.

RECEIVED

JUL 3 1984

W.M. DIST. 14
GRANTS PASS, OR.

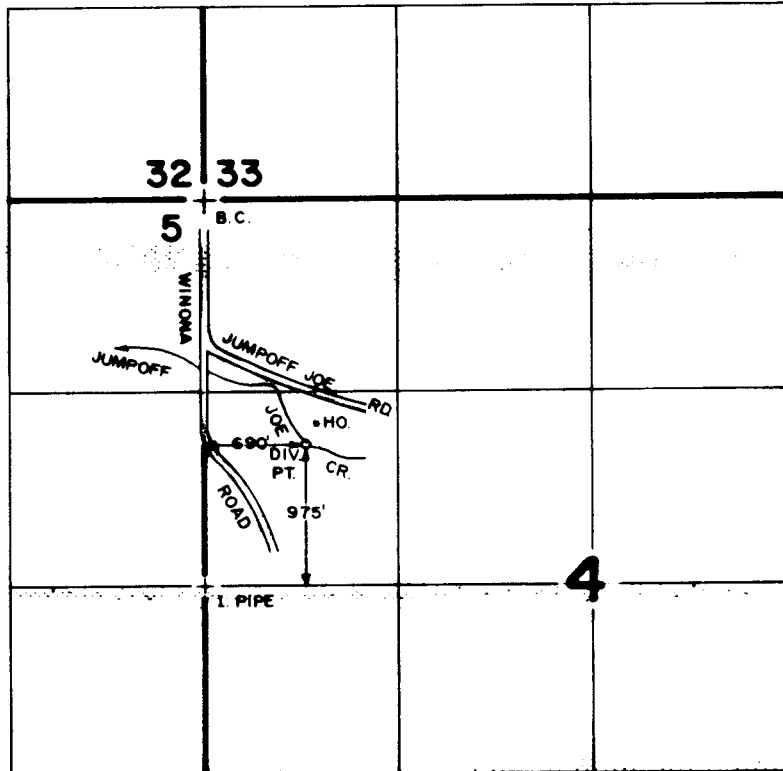

FINAL PROOF SURVEY
UNDER

Application No. 52136 Permit No. 39267
IN NAME OF

ROBERT M. LOBNOW

Surveyed SEPT 14 1982, by B. S. JAMES

SCALE: 4" = 1 MILE

179-133R

TWB