


*why doesn't
all land have an
irrigation watermark?
18 SWSE 158 foot but only
19 NENE 120 foot but no
Irr.?*

*54
539
393*

T. 36 S., R. 6 W., W.M.


38' under WR for Irr

*allow 13 here
ACCORDY 38'
UNDER RR
(P-4364
A-6969)*

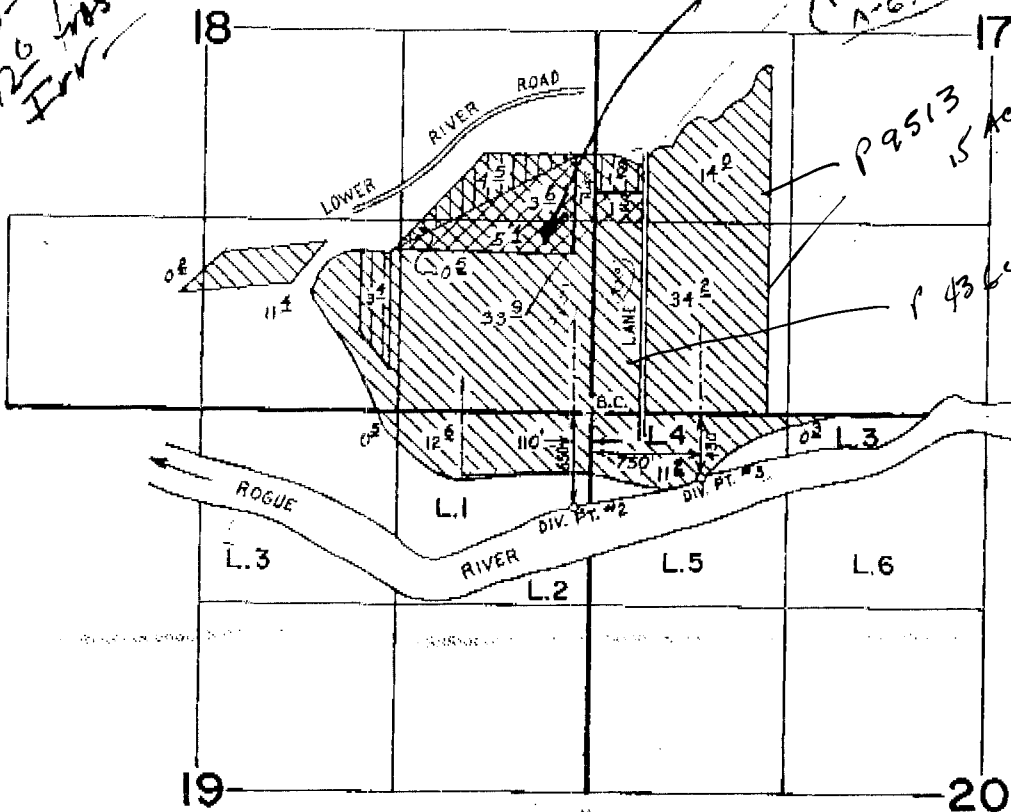

SCALE: 4" = 1 MILE

- IRRIGATED from DIV. PT. #2 (T-3095).
- IRRIGATED from DIV. PT. #2 & #3.
- FROST PROTECTION

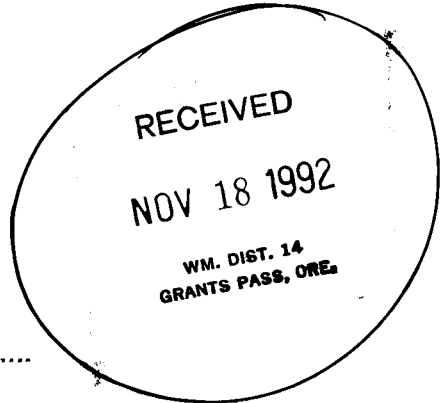

PRELIMINARY FINAL PROOF SURVEY UNDER

TRANSFER NO. 3095
Application No. 52198 Permit No. 39303
IN NAME OF
WILD RIVER ORCHARDS, INC.
Surveyed JAN. 18, 1984, by B. S. JAMES

B50-6-14 *tbl*