


T. 38 S., R. 8 W., W.M.

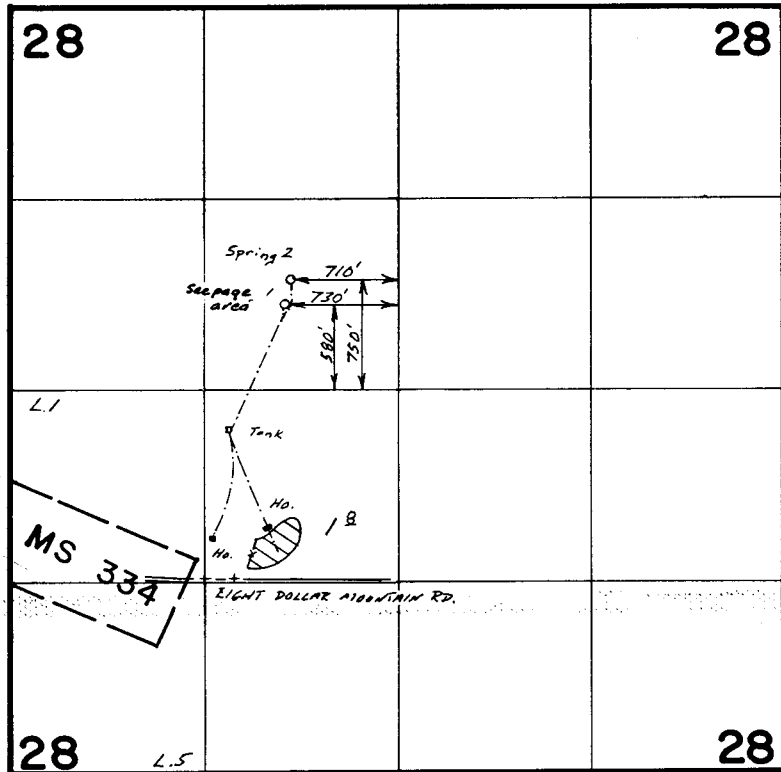

Scale 1"=1320'

RECEIVED

JUL 14 1988

WM. DIST. 14  
GRANTS PASS, OREG.

**FINAL PROOF SURVEY**  
UNDER

Application No. 52209.. Permit No. 39306.....  
IN NAME OF

RONALD E BROOD & ESTATE OF T.E. MARKAM

Surveyed June 9, 1986, by B.S. JAMES.....

41033-179-231R