


T. 38 S., R. 6 W., W.M.

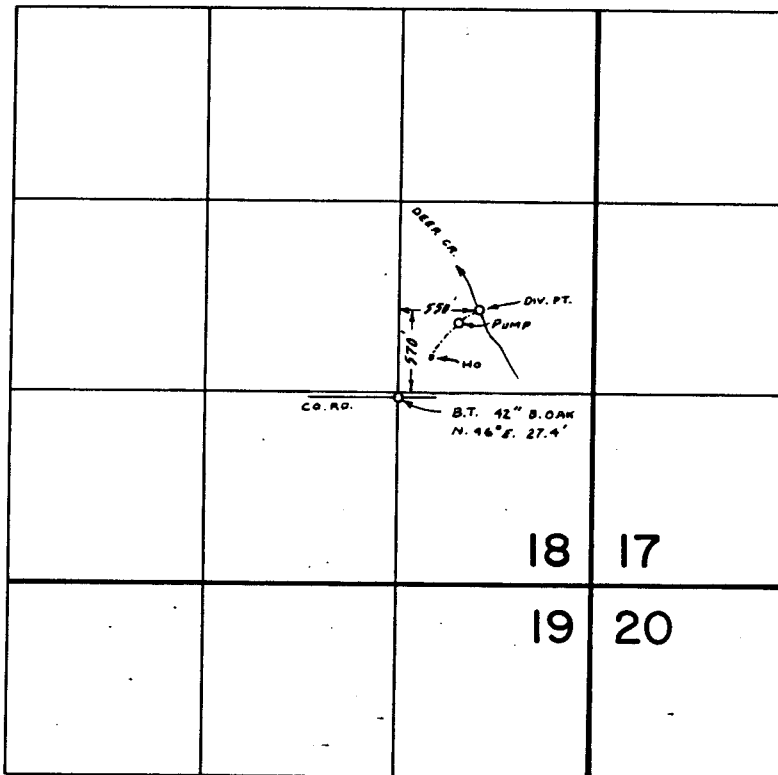

RECEIVED
 OCT 1 1981
 WM. DIST. 14
 GRANTS PASS, ORE

FINAL PROOF SURVEY UNDER

Application No. 52254 Permit No. 39326

IN NAME OF

TERRY CAIN

Surveyed JUL. 17 1978, by B. SUND

P.T.S. - 1978 - 14 - A