


T. 35 S., R. 5 W., W.M.

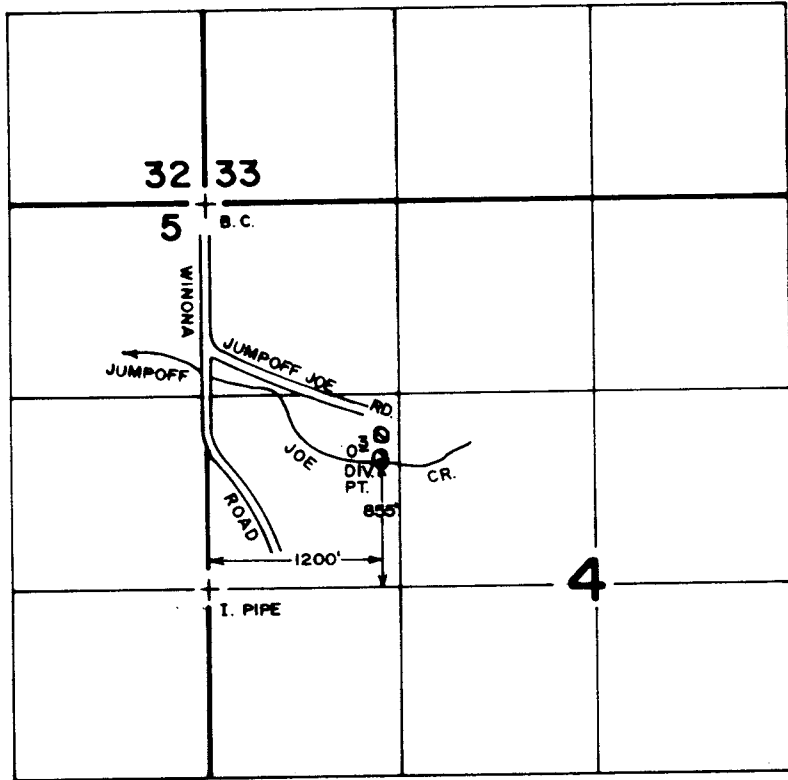

RECEIVED

AUG 27 1984

W.M. DIST. 14  
GRANTS PASS, ORE.

**FINAL PROOF SURVEY**  
UNDER

Application No. 53446 Permit No. 39767 *B. S. JAMES*  
IN NAME OF

**WILLARD D. & PHYLLIS A. LYON**

Surveyed NOV. 18 1982, by B. S. JAMES

SCALE: 4" = 1 MILE

179-133R

TWB