


Permit: S 39338
Volume: 1A
Strm: RICH G
Trib: ROGUE R
Priority: 8/06/74

T.34 S., R.8 W., W.M.

RECEIVED

MAY 21 1981

WM. DIST. 14
GRANTS PASS, ORE

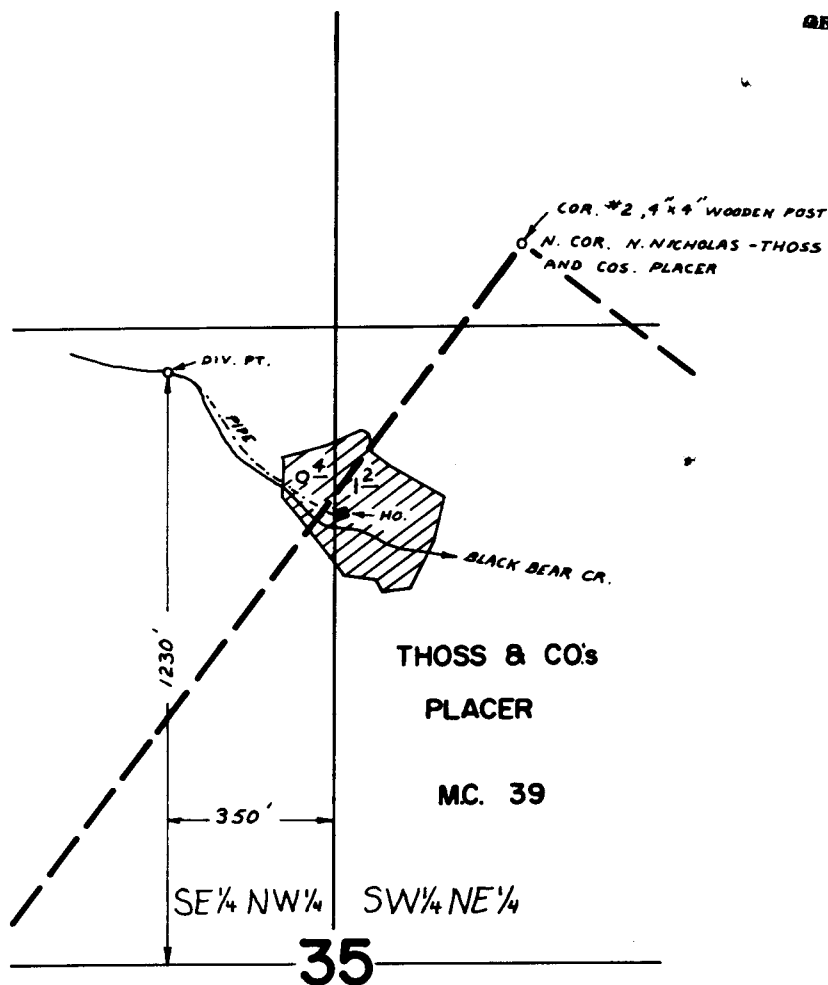

SCALE: 1" = 400 FT.

FINAL PROOF SURVEY UNDER

Application No. 52274 Permit No. 39338

IN NAME OF

LUCY A. & RELF L. PRICE III

Surveyed AUG. 14 1979, by B. SUND