
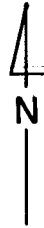


T. 33 S., R. 6 W., W.M.
 Sec. 33

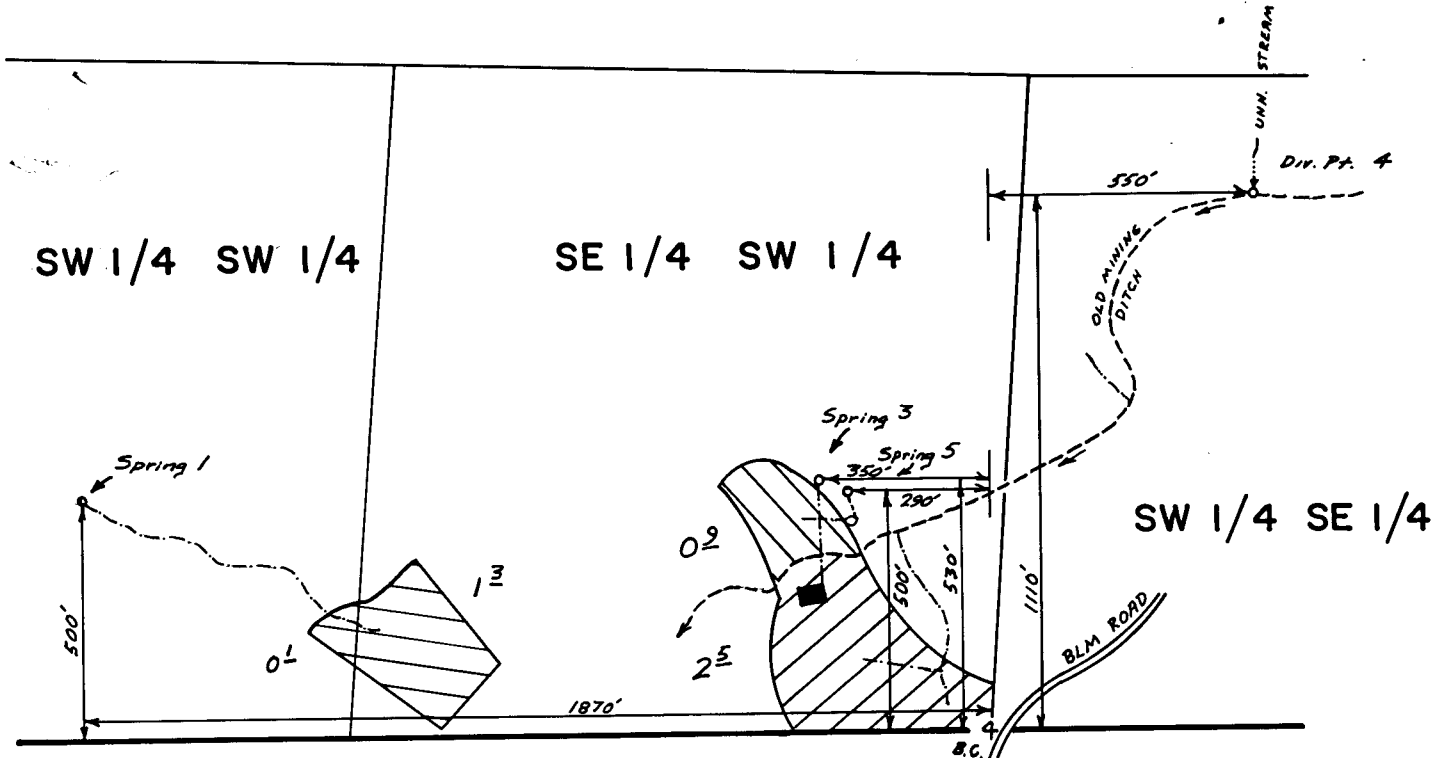

Scale 1"=400'

Spring 1

Div. Pt. 4

Spring 5

FINAL PROOF SURVEY
 UNDER

RECEIVED

APR 1 1987

Application No. 52277 Permit No. 39339
 IN NAME OF

REG. DIST. 14
 GREGG'S PACS, ORE.

.....BUELL M. MARTIN.....

Surveyed Aug. 30, 1984, by J.R. WOODROOF
 April 30, 1986 " B.S. JAMES