


RECEIVED

AUG 12 1974

STATE ENGINEER
SALEM, OREGON

T.I.S.R.2 & 3 W.W.M.

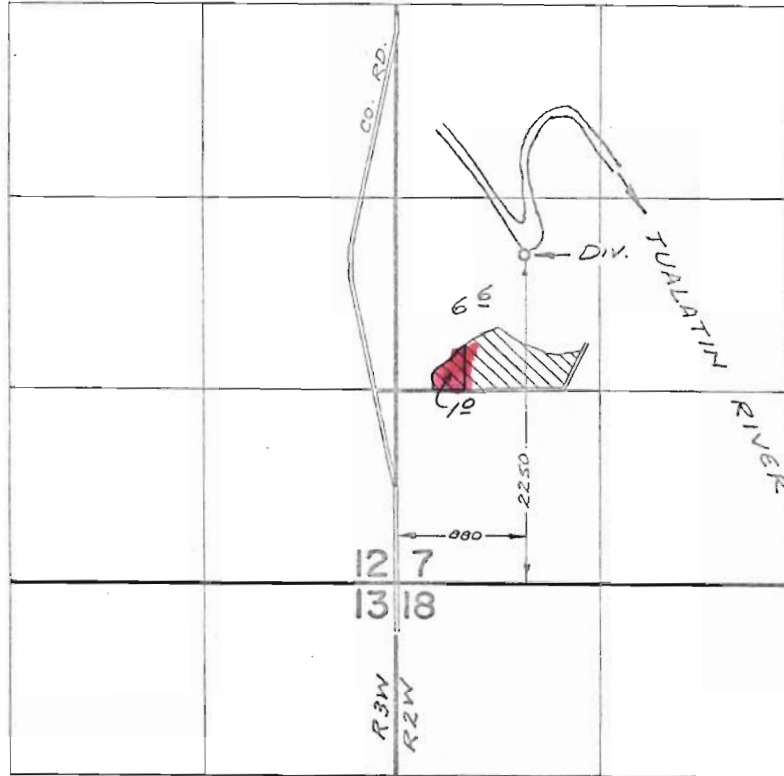

FINAL PROOF SURVEY
UNDER

Application No. 48050 Permit No. 36029
IN NAME OF

CARL ANDREW PIERSON

Surveyed Nov. 3, 1922, by R. MUCKEN

Application No. 52298
Permit No. 39343