


Permit: S 39370  
Volume: 8  
Strm: E FK ILLINOIS R  
Trib: ILLINOIS R  
Priority: 1/23/75

# T.41S., R.8W., W.M.

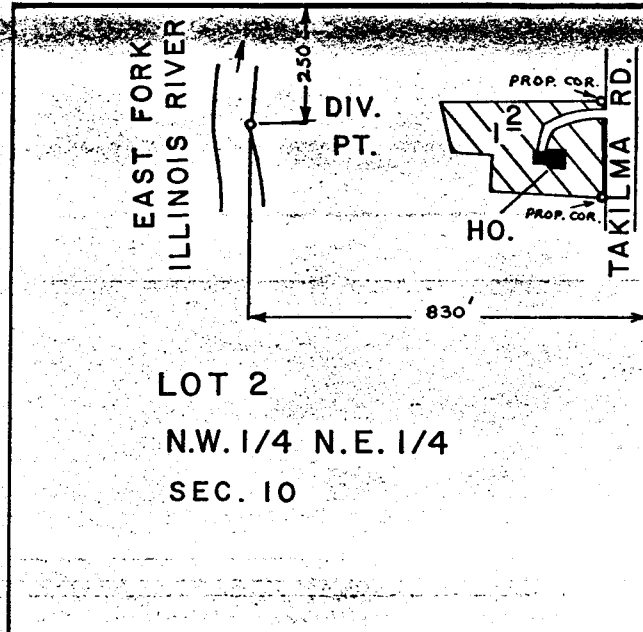

SCALE : 1" = 400 FT.

## FINAL PROOF SURVEY UNDER

RECEIVED  
APR 28 1980  
WM. DIST. 14  
GRANTS PASS, ORE.

Application No. 52734 Permit No. 39370 Cert 49126  
IN NAME OF

WILLIAM R. & CATHERINE G. DUNHAM

Surveyed JUN. 13 1979, by B. SUND D.H.M.

PTS.-1979-14-B