


T.27S. Range 2 West. N.E. Sec. 12

NW Cor.
NE $\frac{1}{4}$ SEC. 12.

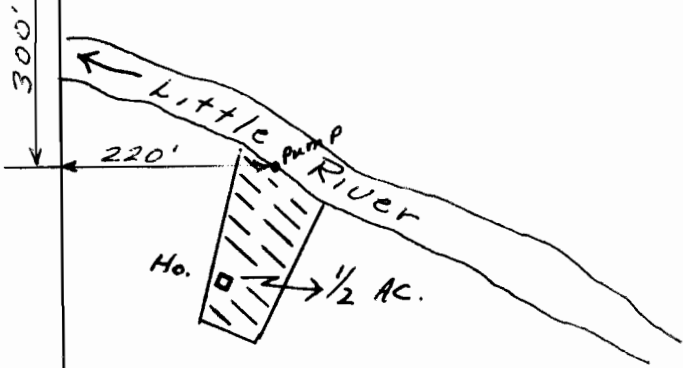

1" = 200'

RECEIVED

SEP 11 1974
STATE ENGINEER
SALEM, OREGON

Application No. 52399
Permit No. 39416