


Permit: S 39498
Volume: 4A
Strm: VANNOY CR
Trib: ROGUE R
Priority: 6/09/75

T. 36 S., R. 6 W., W. M.

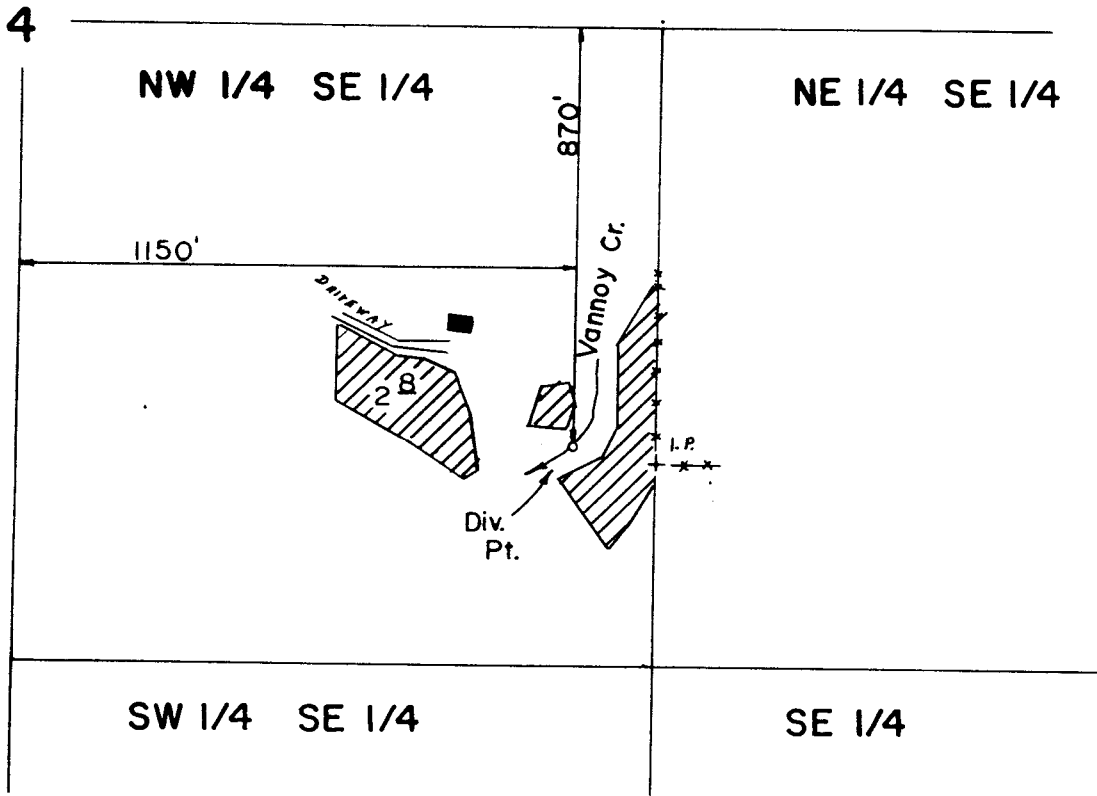

Scale: 1" = 400'

JUN 7 1989

THE STATE OF OREGON

FINAL PROOF SURVEY
UNDER

Application No. 53226 Permit No. 39498
IN NAME OF

GEORGE A. CALVERT

Surveyed SEP. 16. 1987. by B. S. JAMES

PTS-1987-CALVERT

101