


T. 39 S., R. 5 W., W. M.

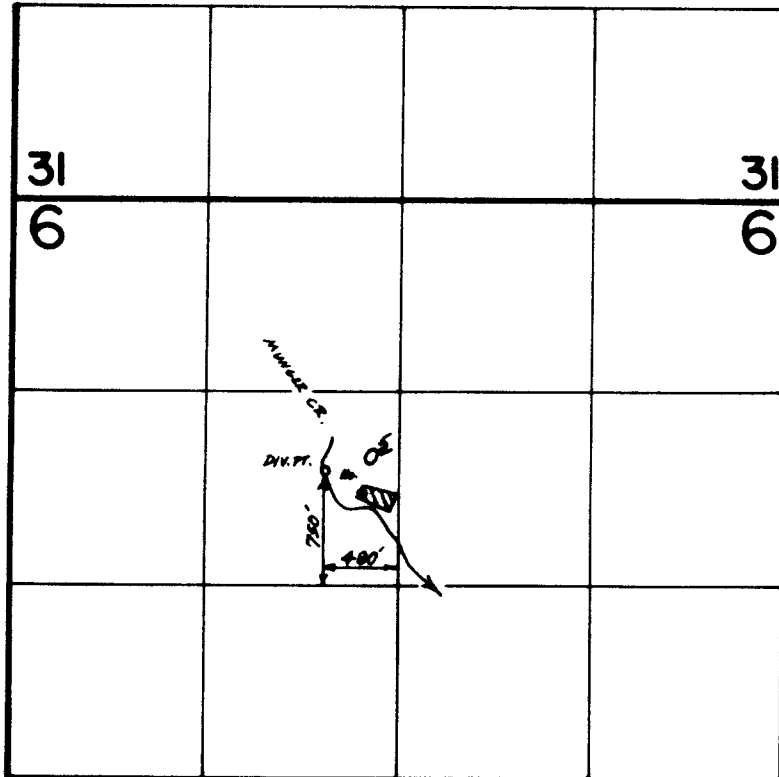

Scale 1" = 1320'

RECEIVED

MAR 25 1988

FINAL PROOF SURVEY
UNDER

VIA DIST. 14
GRANTS PASS, OREG.

Application No. **53288**. Permit No. **39544**.....
IN NAME OF

..... **HUI ALOHA**

Surveyed Aug. **15**... **1984**., by **B.S. JAMES**.....