


18 T30. S. R1. W. WM.

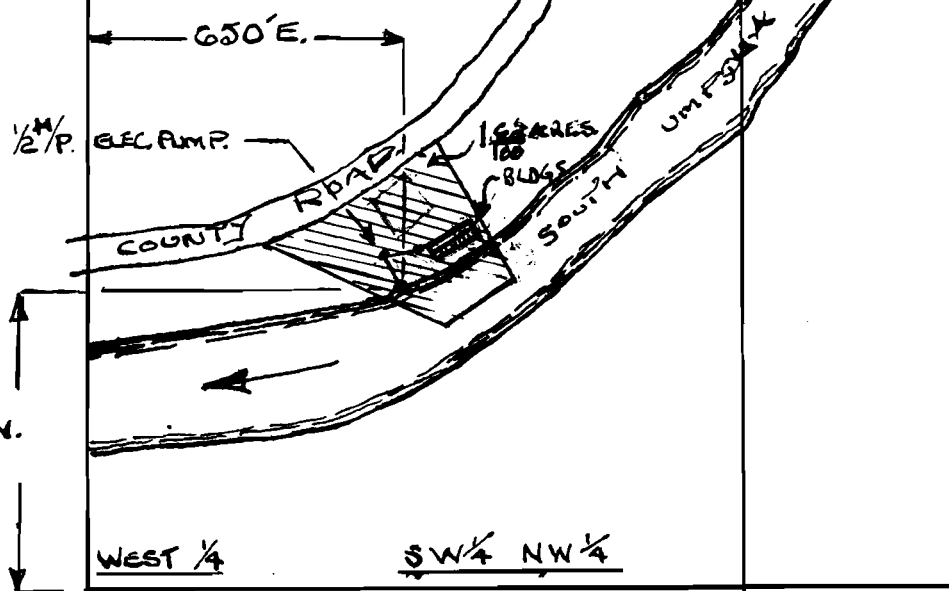

*1/3 rd  
Sta. Pite  
Cont. P.D.*



**RECEIVED**

JUN 26 1975

STATE ENGINEER  
SALEM, OREGON

**Application No.**  
**Permit No.**

53317

39560