


T.37S., R.7W., W.M.

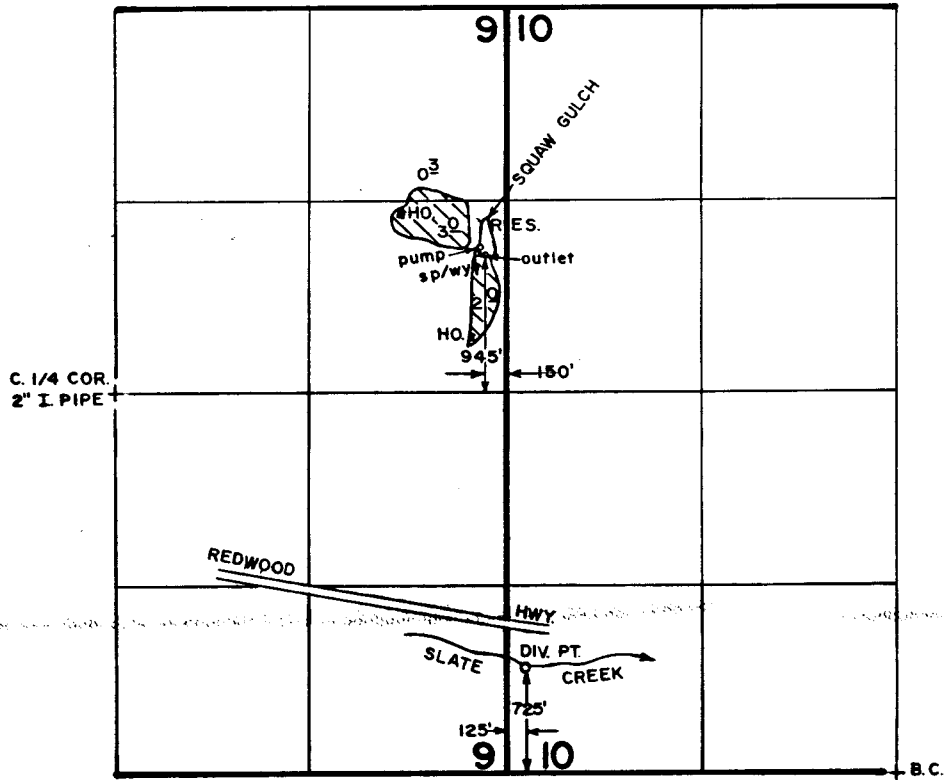

FINAL PROOF SURVEY
UNDER

R-53363 R-6340

Application No. 53364 Permit No. 39590

IN NAME OF

JAMES W. & DAVID A. BASSETT

Surveyed OCT. 25 19.83 by B. S. JAMES

RECEIVED

SEP 4 1990

W.M. DIST. 14
CLINTS PASS, ORE.

179-170L

TWB