


Permit: S 39597  
 Volume: 8A  
 Strm: SALT G  
 Trib: DEER CR  
 Priority: 7/22/75

APR 28 1982

WM. DIST. 14  
 GRANTS PASS, ORE.

T. 38 S., R. 78 & 8 W., W.M.

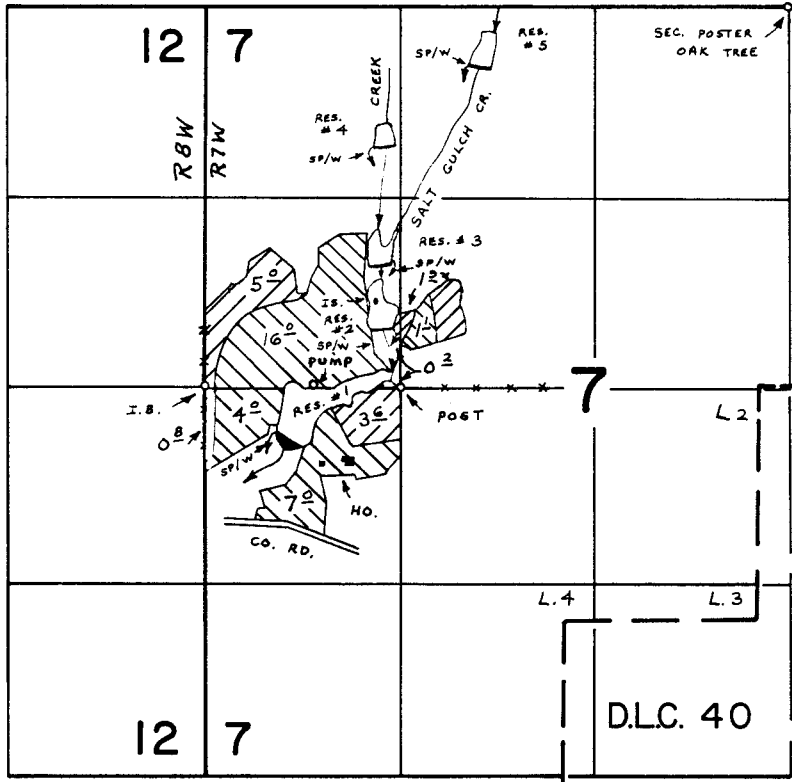

DIV. PTS. LOC.: RES. # 1 - 360'S. & 570'E., # 2 - 400'N. & 1220'E., # 3 - 870'N. & 1200'E., # 4 - 1640'N. & 1240'E., # 5 - 2200'N. & 1860'E., ALL FROM W. 1/4 COR., SEC. 7.

**FINAL PROOF SURVEY**

UNDER

R-52619  
 R-53637  
 52653

R-6320  
 R-6344  
 39459

Application No. 53450... Permit No. 39597...  
 IN NAME OF

*Tall Timber Ranch*

Surveyed SEPT. 26 1977, by B. SUND

SUPPL.  PRIMARY  
 SUPPL.

D.H.M.  
 P.T.S. - 1977 - 14 - B  
 & P.T.S. - 1970 - A