


T.2S. R.40E. W.M.

Application No. R-52725 + 52726  
Permit No. R 6363 & 39612

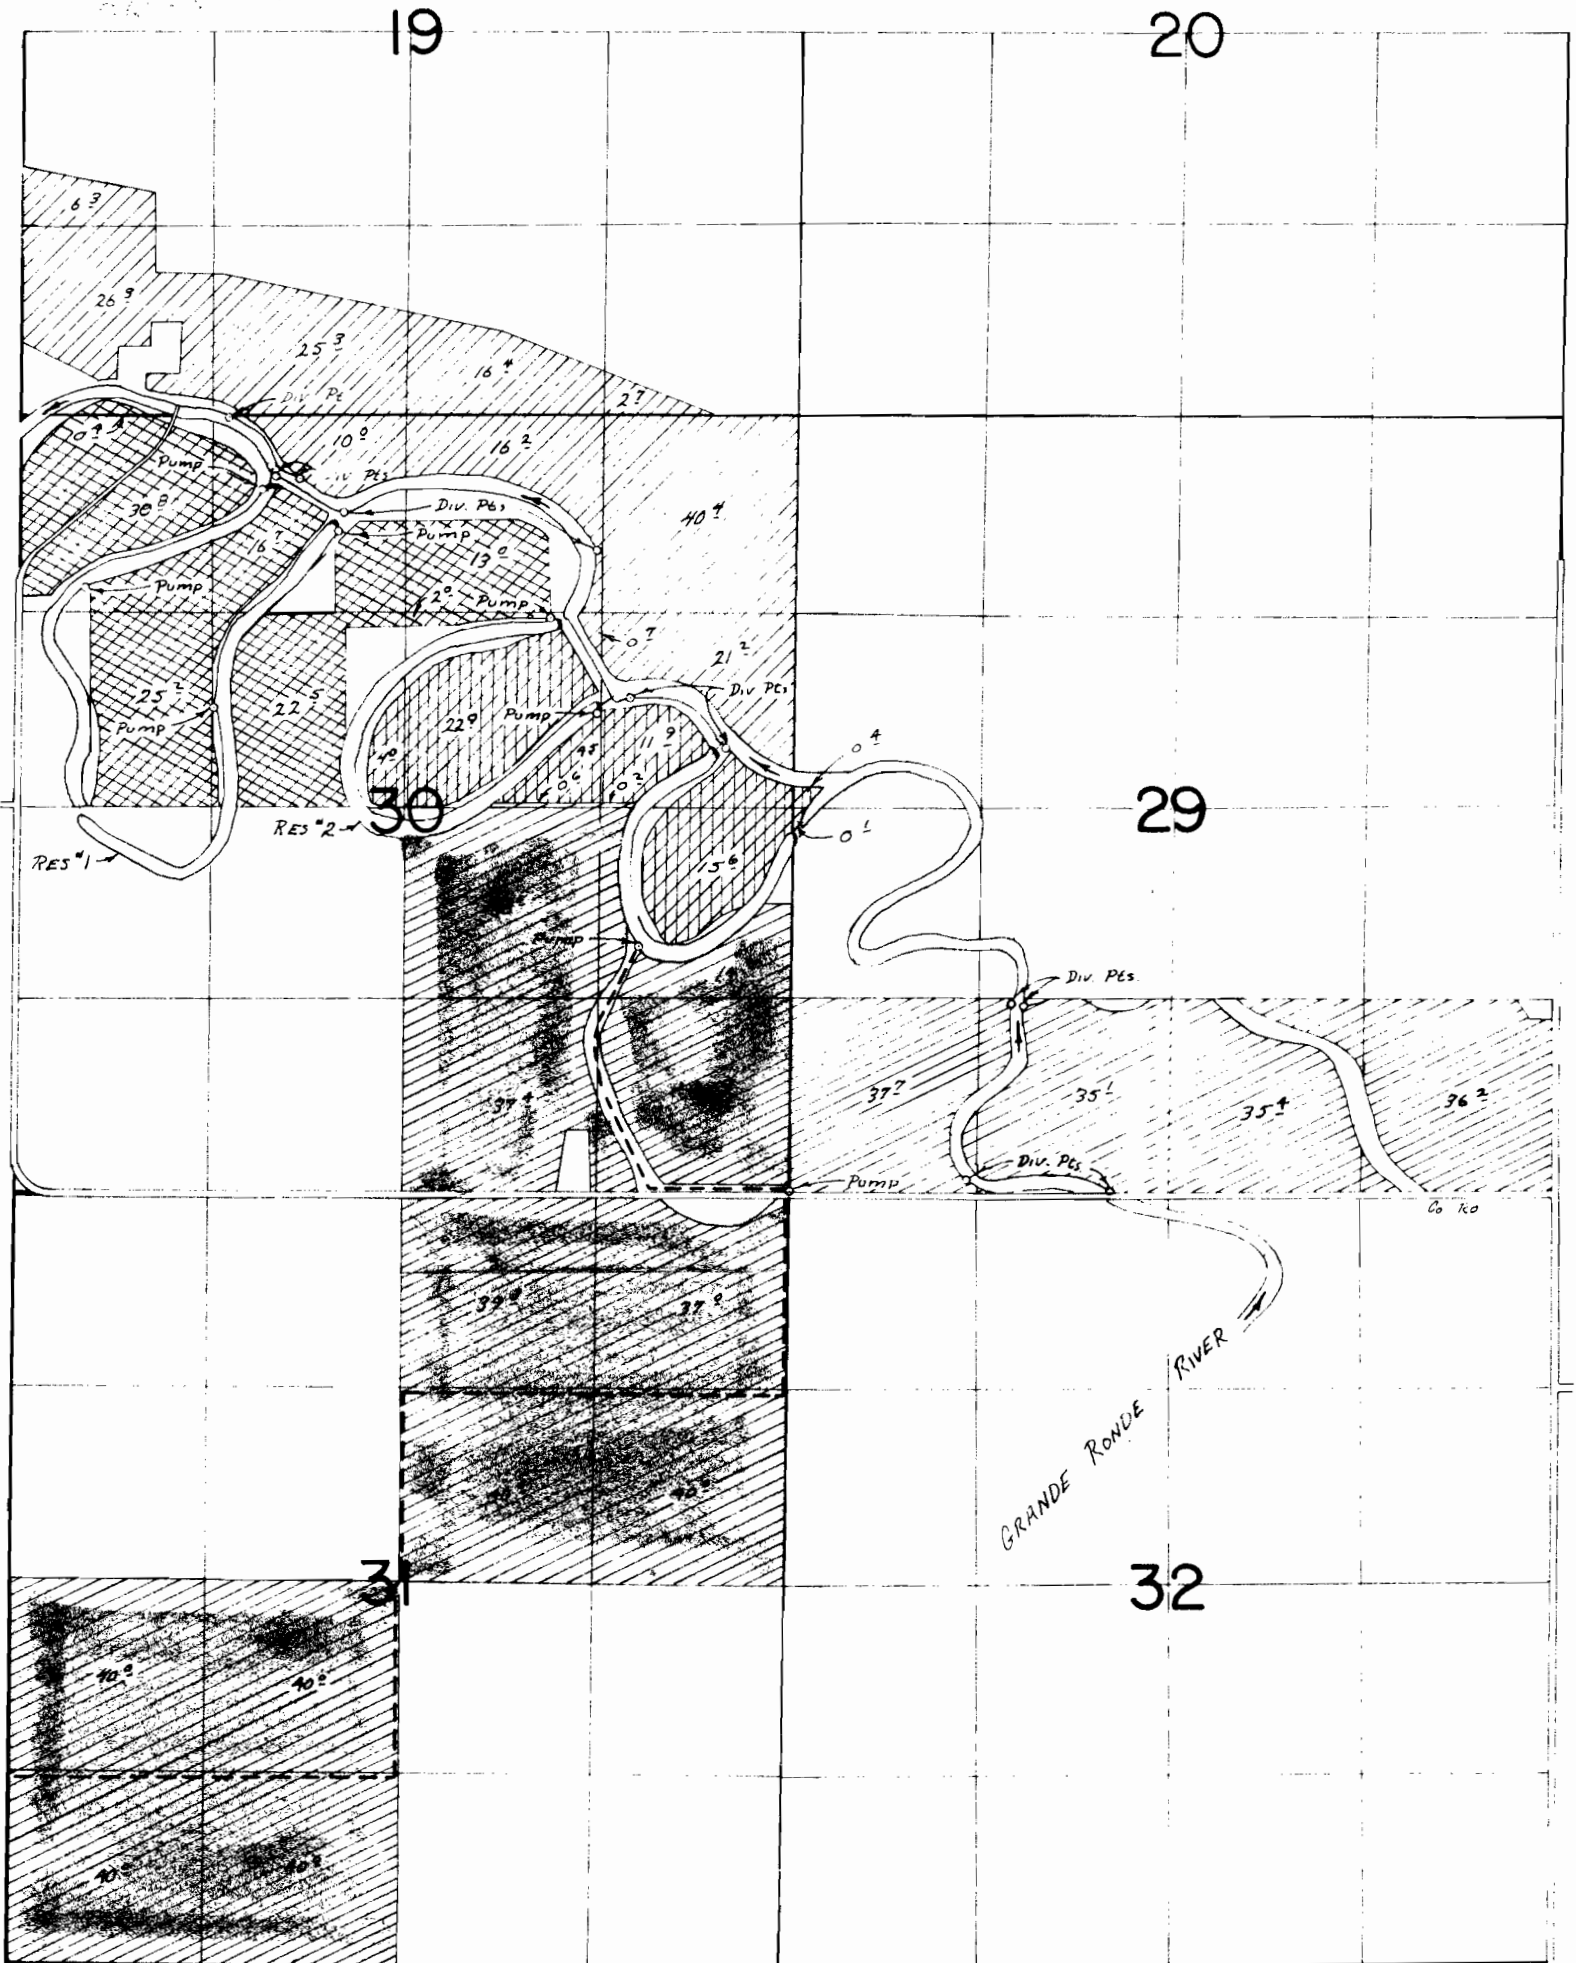

Div. Pts. Loc. : \*1-5270' N \* 3900' W ; \*2-4890' N \* 3570' W ; \*3-4860' N \* 3420' W ; \*4-4640' N \* 3110' W ; \*5-4400' N \* 1360' W ; \*6-3400' N \* 1130' W ; \*7-3050' N \* 470' W ; \*8-1300' N \* 1500' E ; \*9-1280' N \* 1600' E ; \*10-120' N \* 1200' E ; \*11-60' N \* 2200' E  
 RES. LOC. : RES #1-4940' N \* 3630' W ; RES #2-3390' N \* 1260' W ;  
 ALL FROM SE COR. SEC. 30 T.2S. R.40E. W.M.

	Primary River Permit 28798		SUPPLEMENTAL RES # 1
	Primary River Permit 30036		SUPPLEMENTAL RES # 2

*Supplemental from Res # 3*

### FINAL PROOF SURVEY UNDER

RR - 37688	28798
RR - 38492	R-4502
RR - 38493	R-4503

Application No. 38495 Permit No. 30036

IN NAME OF

RUSSELL ELMER

Surveyed July 18, 1973, by ROBERT G. MUCKEN