
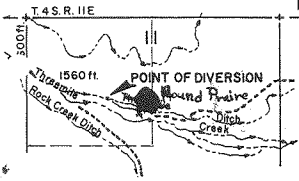


# PINE HOLLOW CO OPERATIVE INC.

ROUTE 1 BOX 94  
TYGH VALLEY, ORE.

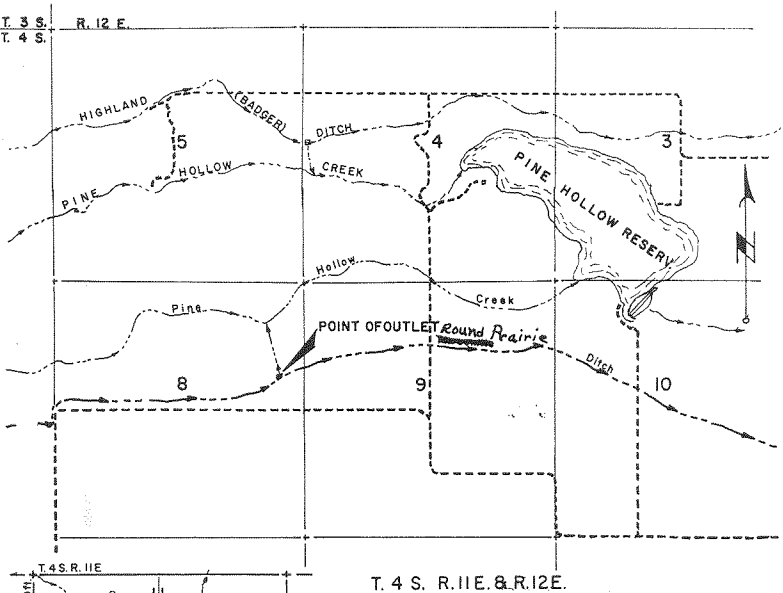

Application No. R-53062 & S 3066  
Plan No. R 6368 / 39616