


APPLICATION NO 6358.

PERMIT NO. 3962.

T. 2 S., R. 11 W.W.M.

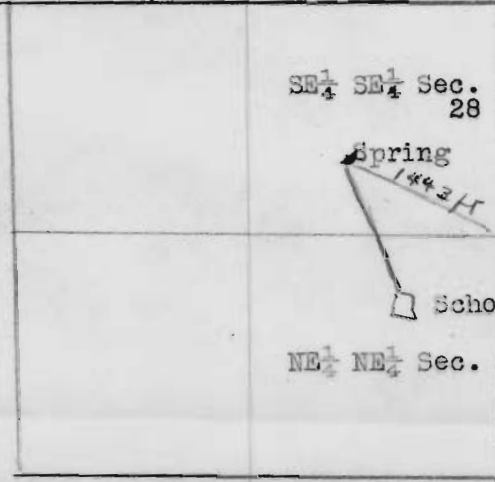

--Sec. Cor. between Secs. 27, 28, 33 & 34.

Schoolhouse,

OFFICE OF STATE WATER BOARD
RECEIVED

JAN 16 1922

SALEM,

OREGON.