

SEE MAP IS 8

1001

1002

700

600

100

9-12

CANCELLED
800
900

SEE MAP IS 8

9-1

PANTHER CREEK

TRASK


RIVER

TRASK RIVER

ROAD

R.R. SPIKE
TIED
1980-H-1


PUBLISHERS
EASEMENT

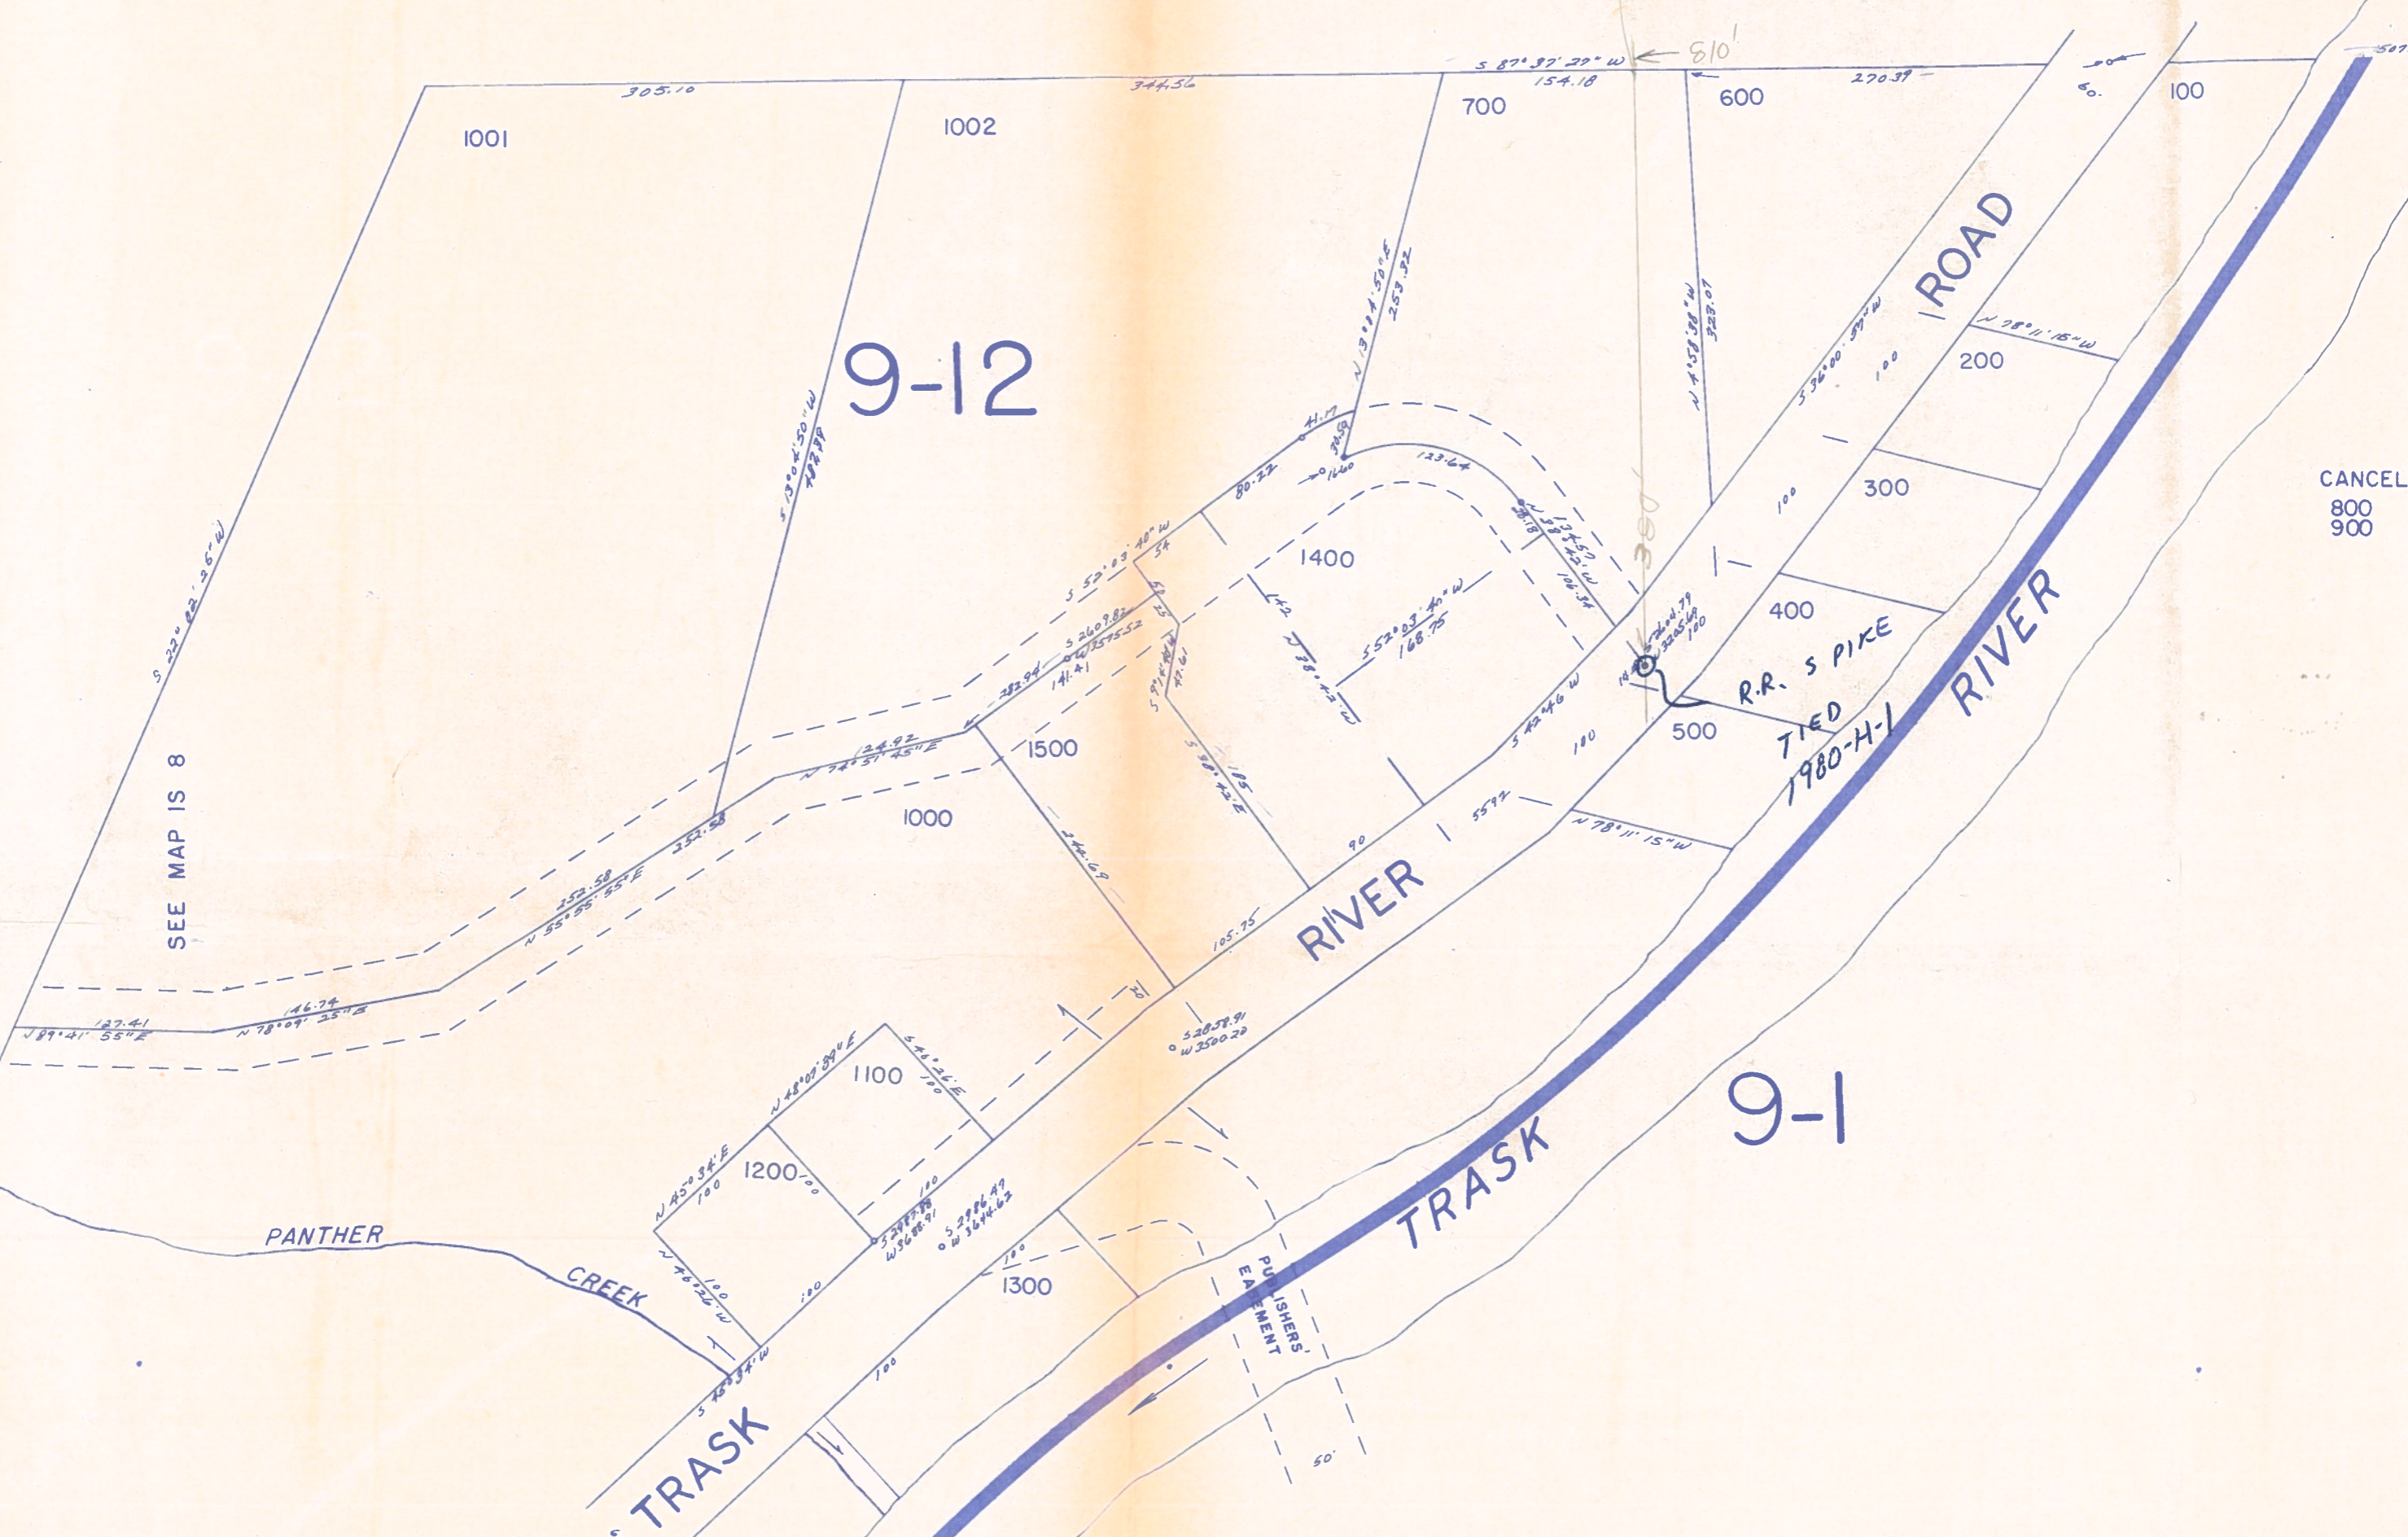

SECTION 30 TOWNSHIP 1-S RANGE 8W WM



SCALE
1" = 200 FT

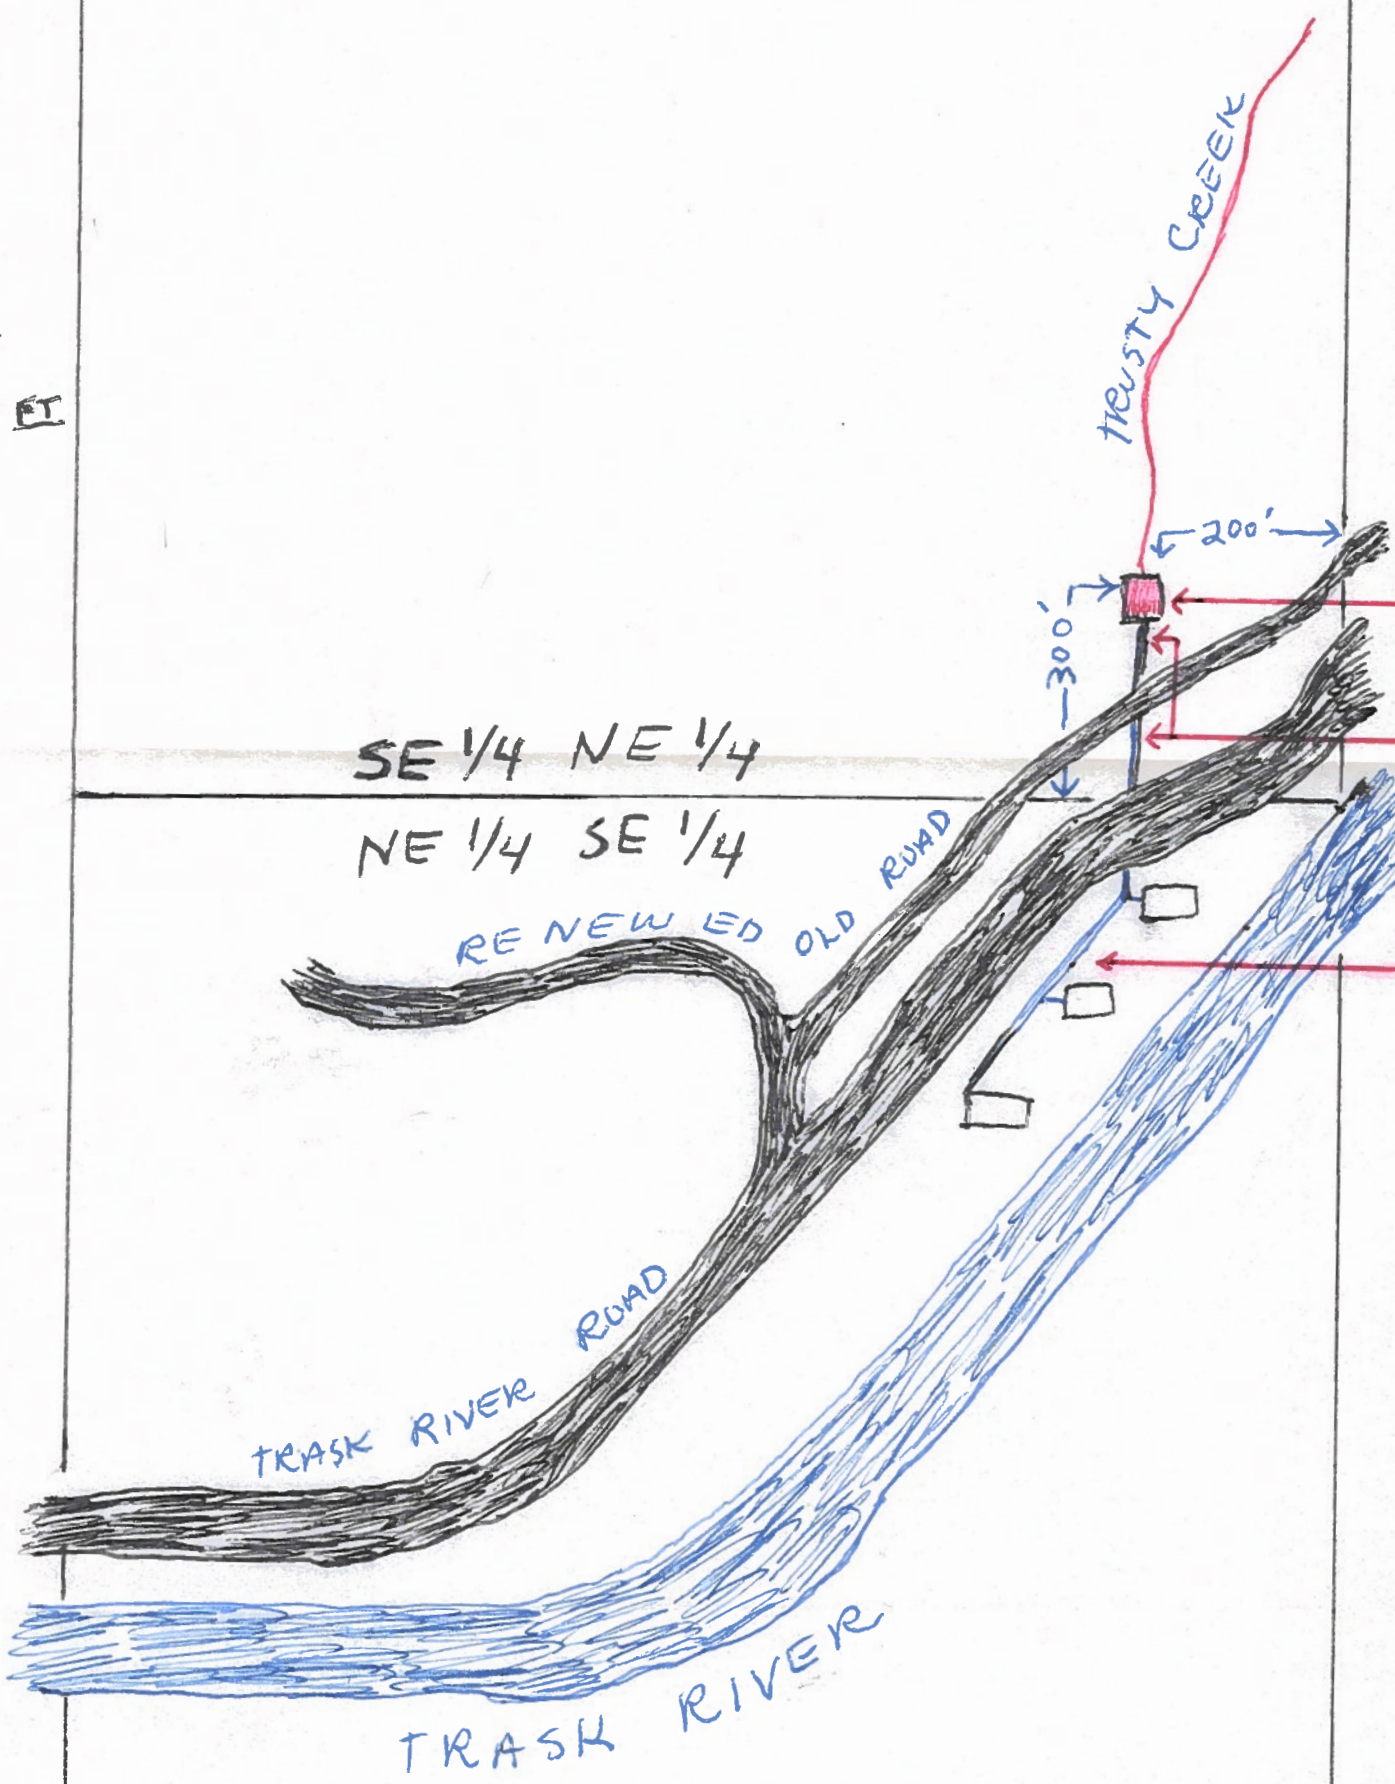

50 FT SQUARE EASEMENT
 WATER PLANT SITE
 300' LONG
 10' WIDE EASEMENT
 2" WATER LINE

SE 1/4 NE 1/4
 NE 1/4 SE 1/4

RENEWED OLD ROAD

TRASK RIVER ROAD

TRASK RIVER

WATER LINE
 2" PIPE - PLASTIC

RECEIVED

JAN 7 1975

STATE ENGINEER
 SALEM, OREGON

DATE 1/6/75

Jack V. Trusty
 APPLICANT

Jack V. Trusty
 RT. 1 - BOX 399
 Bay City, Oregon 97107
 Phone: 842-4188

APPLICATION # 52596

Permit No. 39662