


39668

397-11

T. 37 S., R. 7 W., W. M.

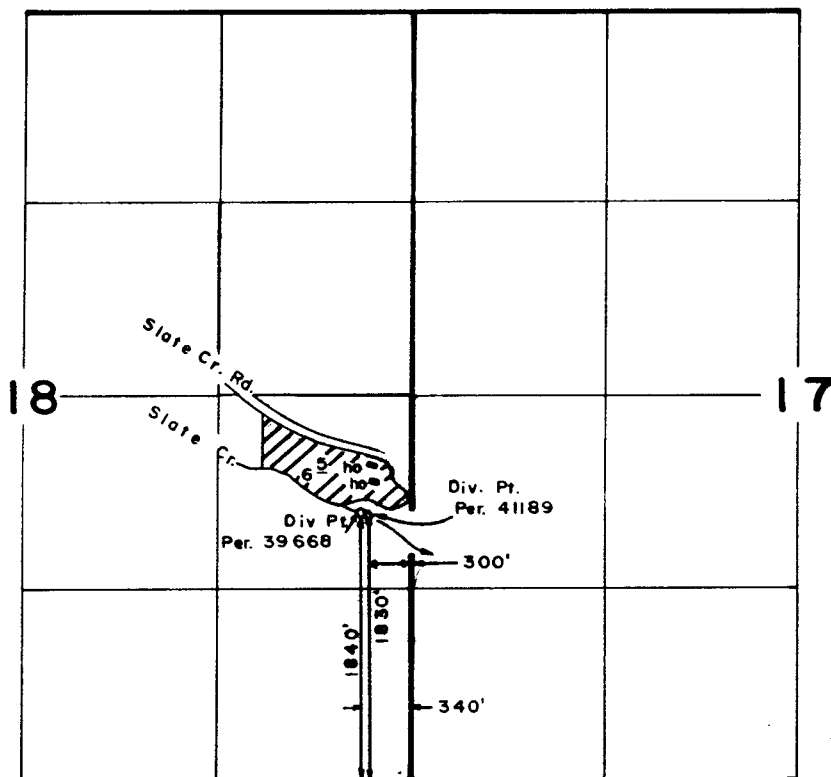

MAY 29 1989

W. L. JAMES & SONS, INC.

Scale: 1" = 1320"

FINAL PROOF SURVEY UNDER

52614 39668

Application No. 54912 Permit No. 41189.....

IN NAME OF

NORMAN E. & DAISY T. BILLER

Surveyed JUL. 23. 1986, by B. S. JAMES...

41033-179-197R

LML