


T. 37 S., R. 6 W., W.M.

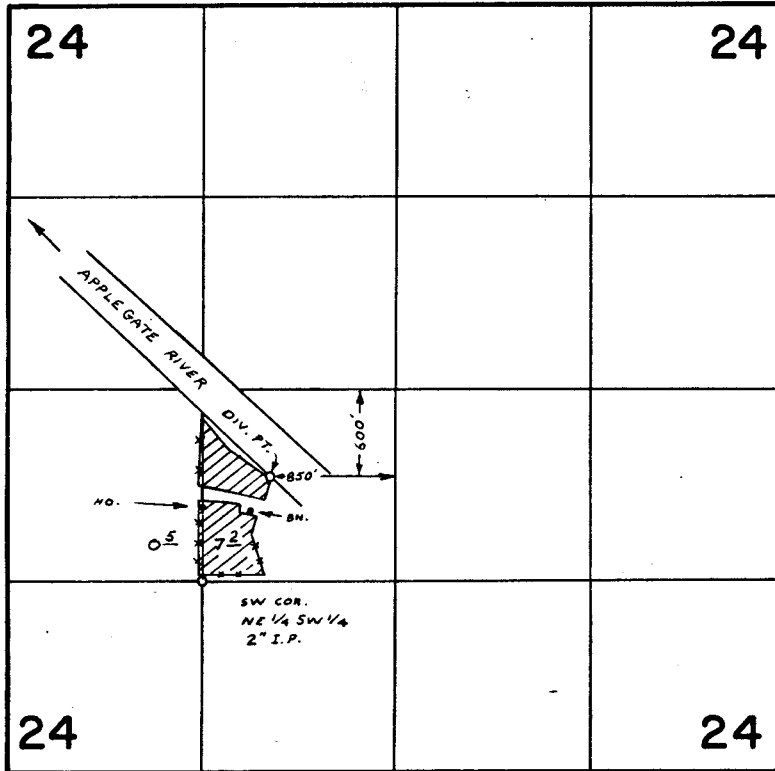

RECEIVED
OCT 1 1981
W.M. DIST. 14
GRANTS PASS, ORE.

FINAL PROOF SURVEY
UNDER

Application No. 52617 Permit No. 39669
IN NAME OF

MICHAEL W. & NANCY I. MEER

Surveyed OCT. 3 1978, by B. SUND

P.T.S. - 1978 - 14 - C