


W. W. BONES PARK  
T7S, R10W, SEC. 30, NW $\frac{1}{4}$

RECEIVED

FEB 4 1975

STATE ENGINEER  
SALEM, OREGON

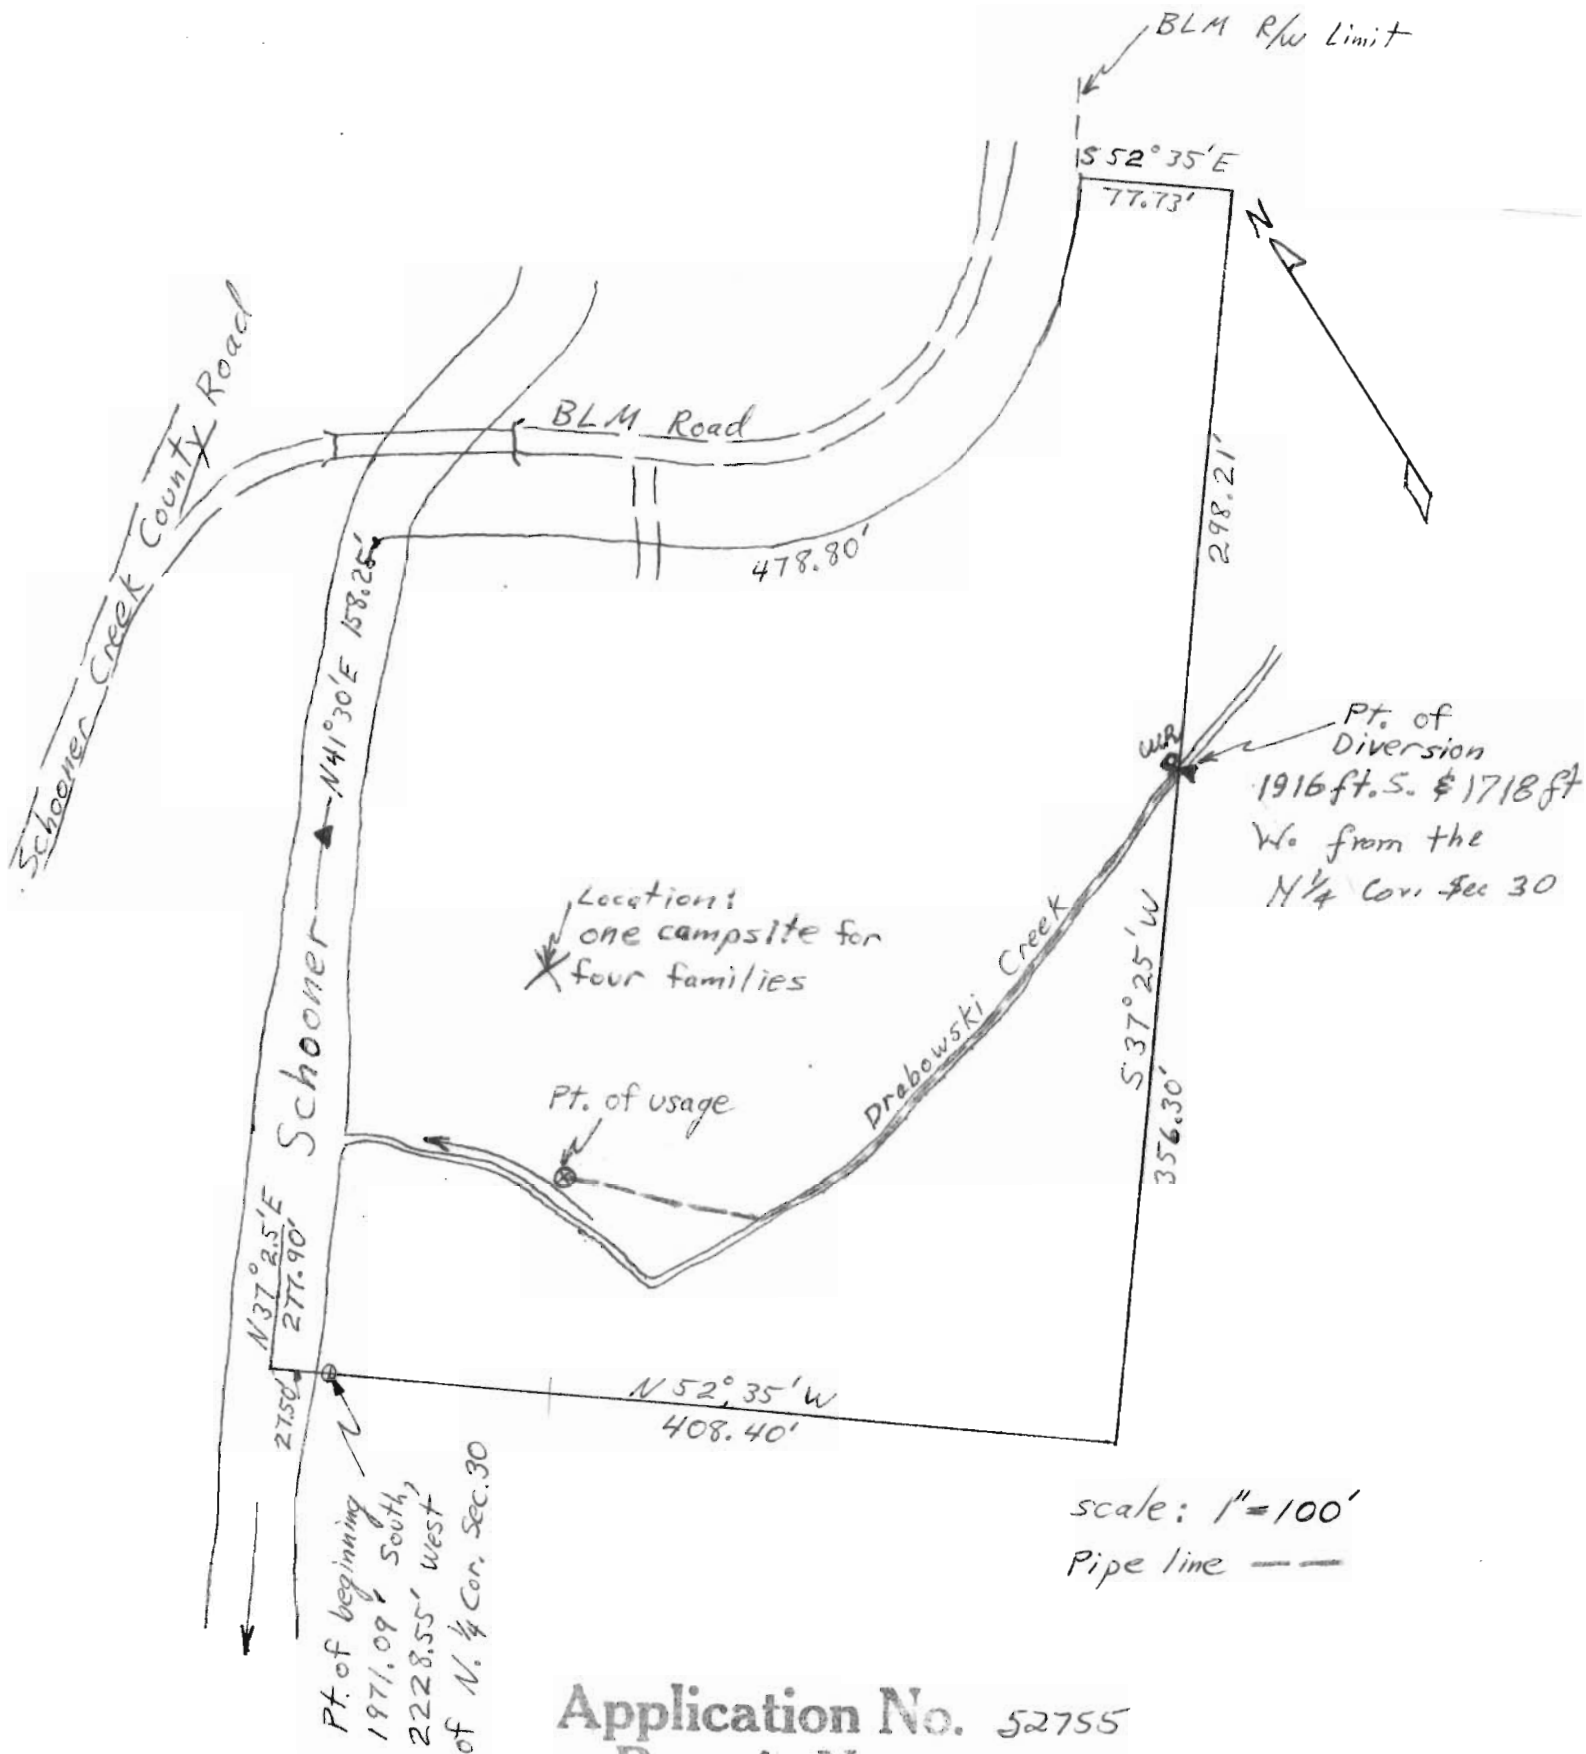

Application No. 52755  
Permit No. 39718