


43:50

RECEIVED  
JUL 11 1975  
WATER RESOURCES DEPT.  
SALEM, OREGON

T.5S.R.1E.W.M.

4" = 1 Mile

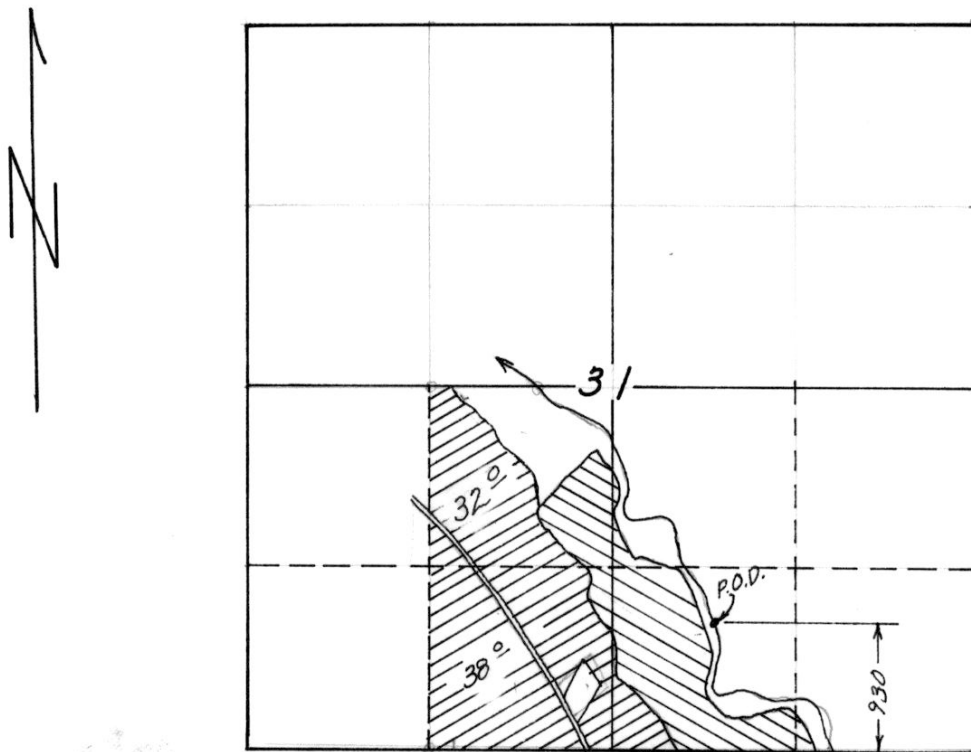

Application No. 53407

Permit No. 39747

AAA Farms



New application



Permit No. 16524