


Application No. 53435  
Permit No. 39760

RECEIVED

JUL 21 1975

WATER RESOURCES DEPT.  
SALMON, OREGON

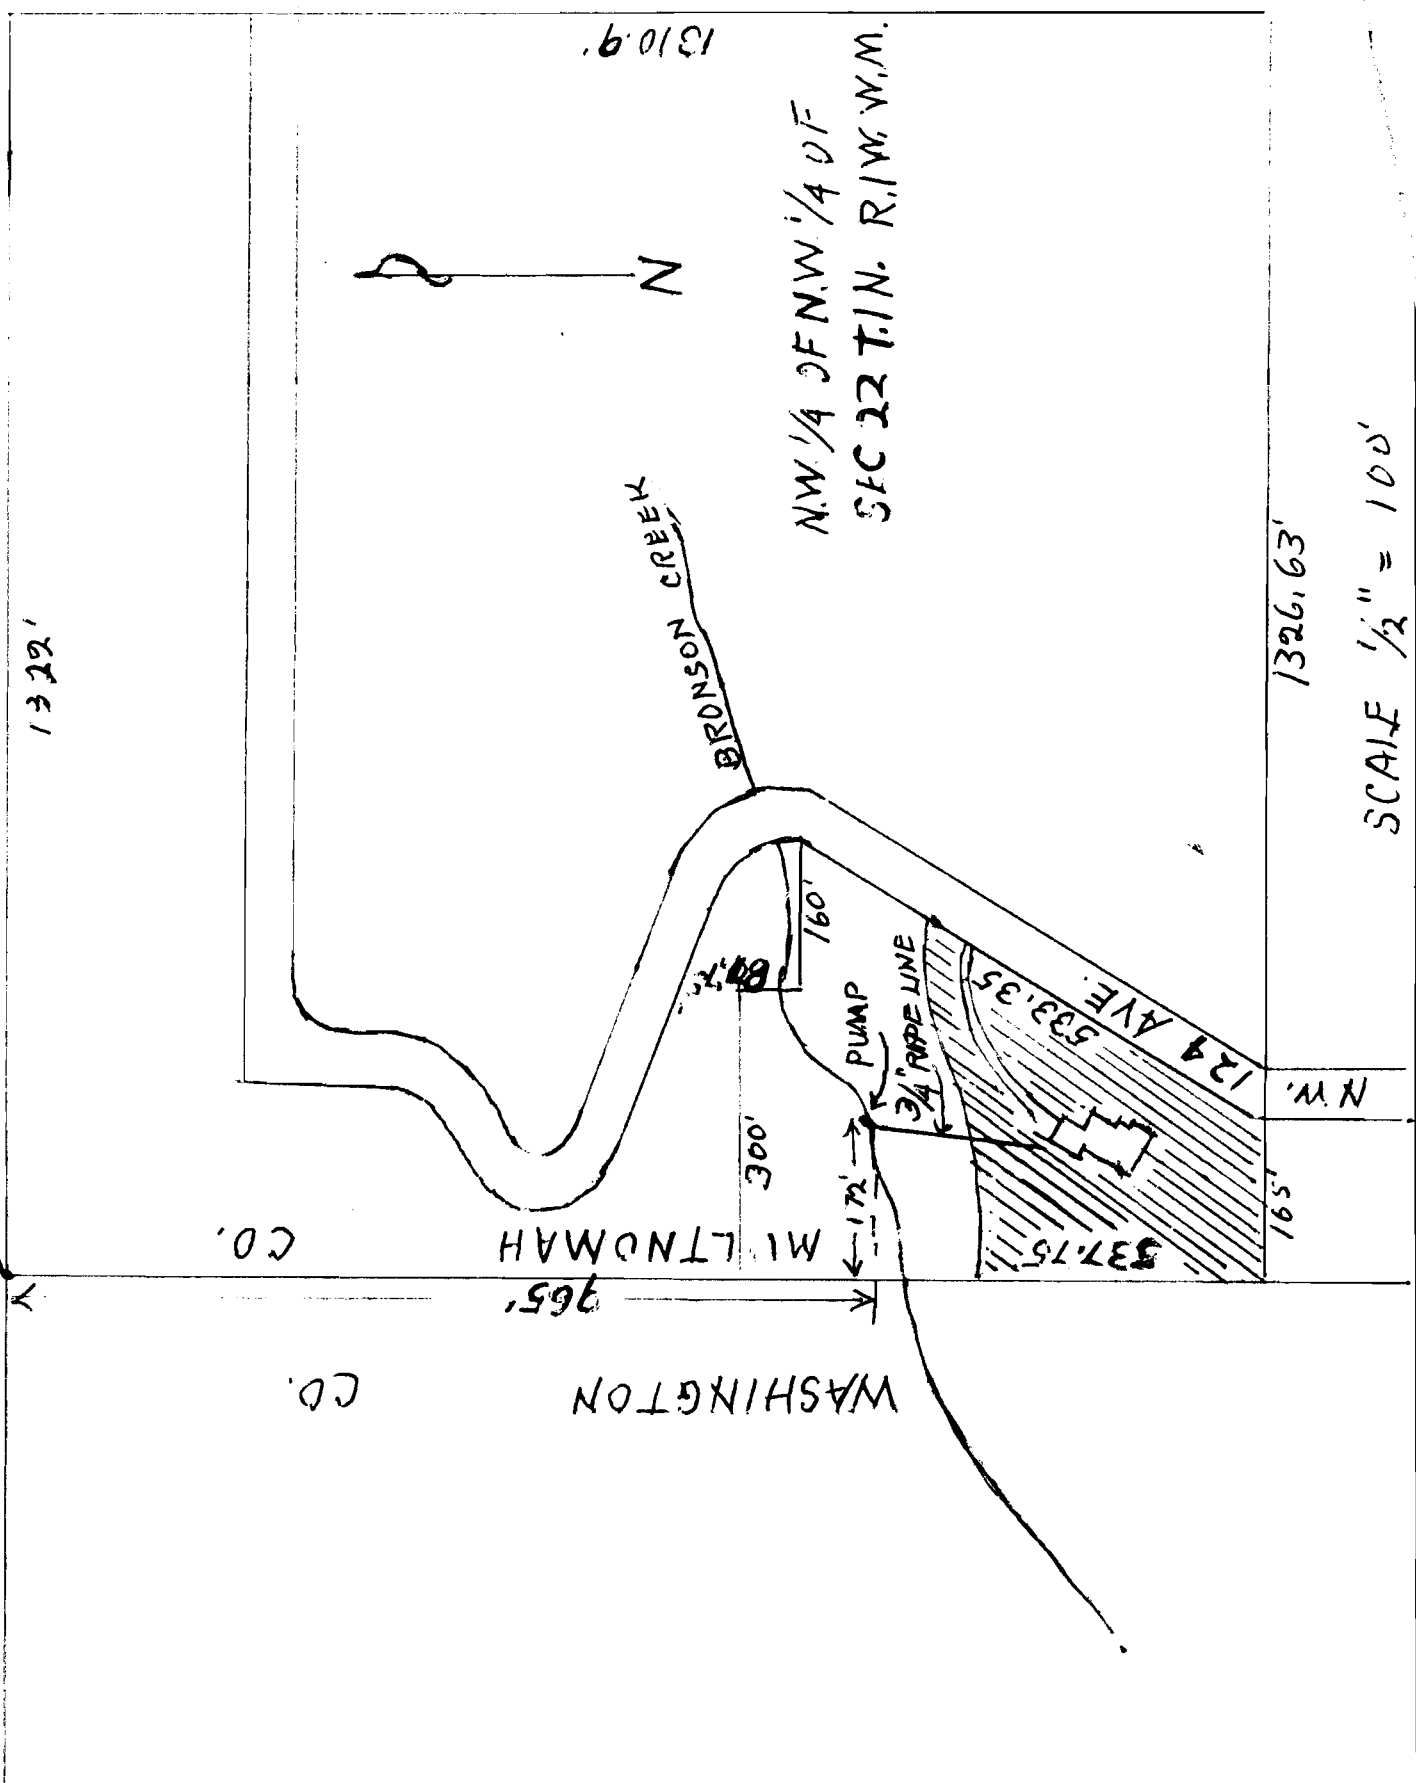

SCALE 1/2" = 100'