


Application No. 53466
 Permit No. 39778

RECEIVED

JUL 28 1975

WATER RESOURCES DEPT.
 SALEM, OREGON

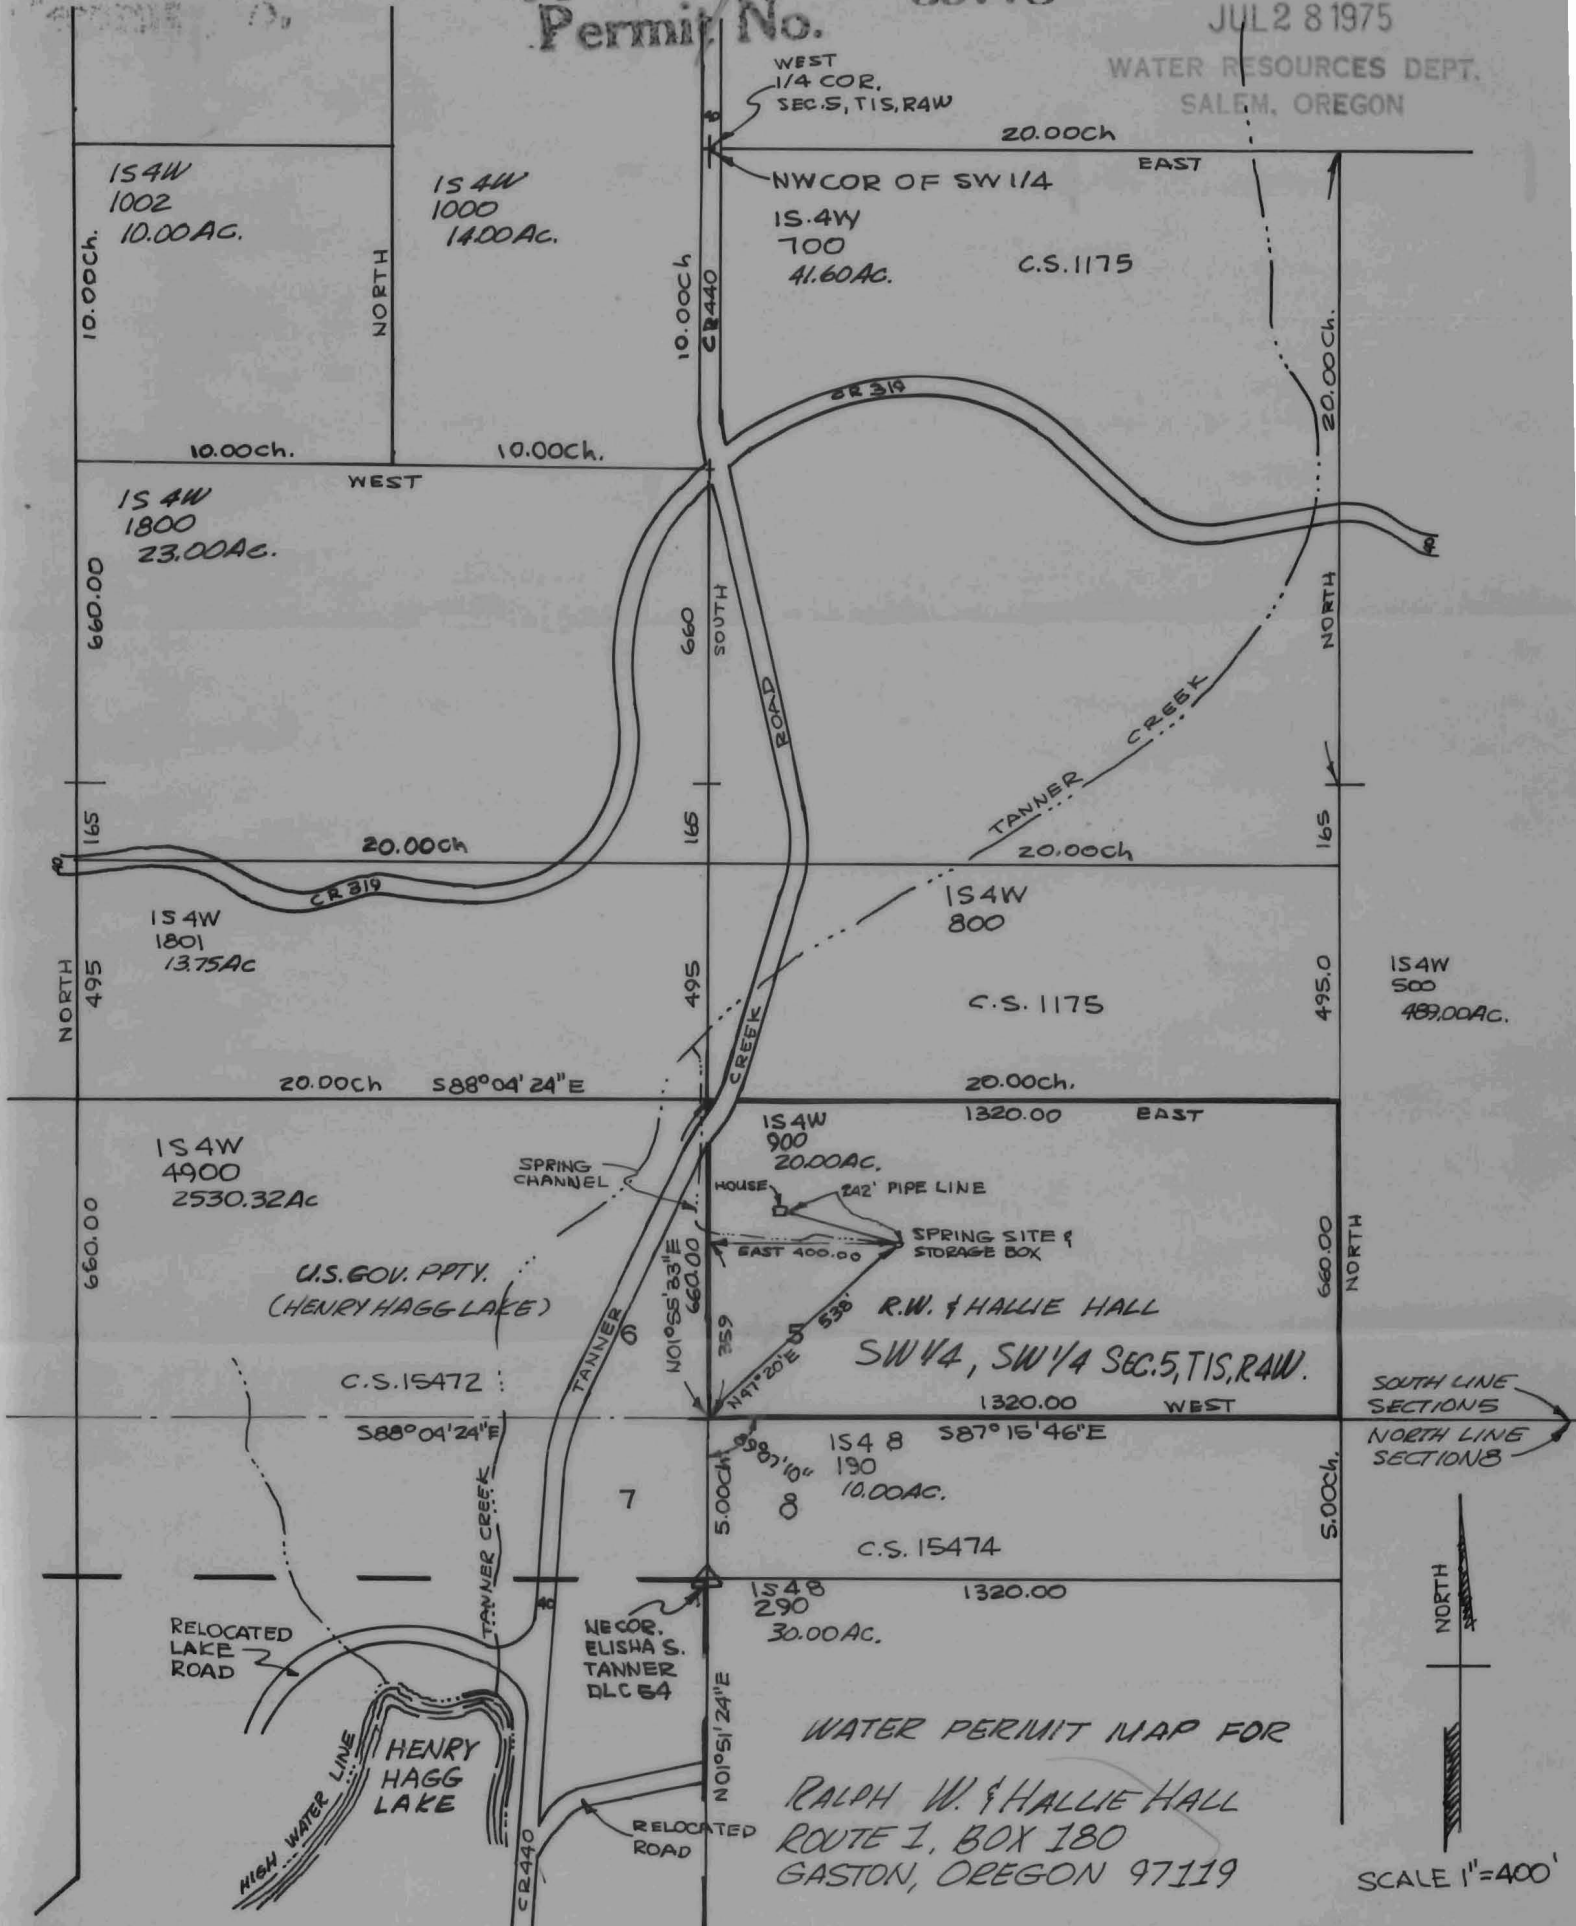

SOUTH LINE SECTIONS
 NORTH LINE SECTIONS



SCALE 1"=400'

WATER PERMIT MAP FOR
 RALPH W. & HALLIE HALL
 ROUTE 1, BOX 180
 GASTON, OREGON 97119

M.L. BLEHM 7.23.75