


T. 26 S. R. 3 W. N.E. Sec. 33

RECEIVED

AUG 1 1975

WATER RESOURCES DEPT.
SALEM, OREGON

Unno'd.
Stream

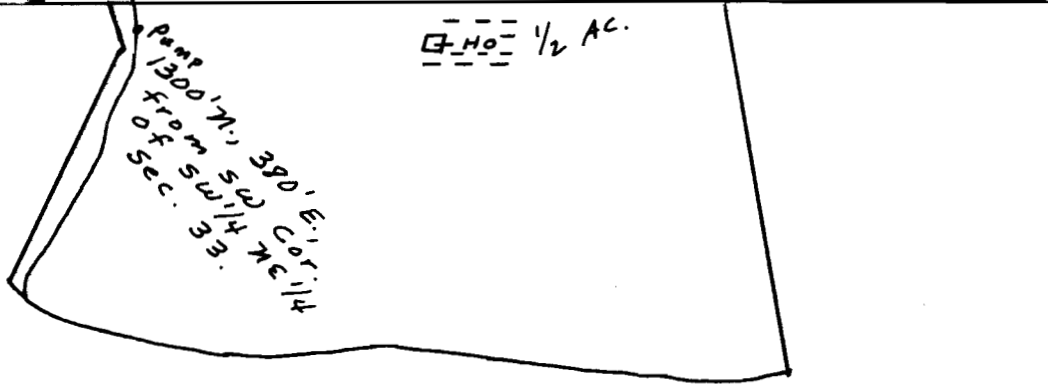

A
N.

SW 1/4 NE 1/4

Application No. 53493

Permit No. 39794

SW Cor. of
SW 1/4 NE 1/4
Sec. 33

1" = 200'