


T.35 S., R.7 W., W.M.

RECEIVED

OCT 8 1980

WM. DIST. 14
GRANTS PASS, ORE.

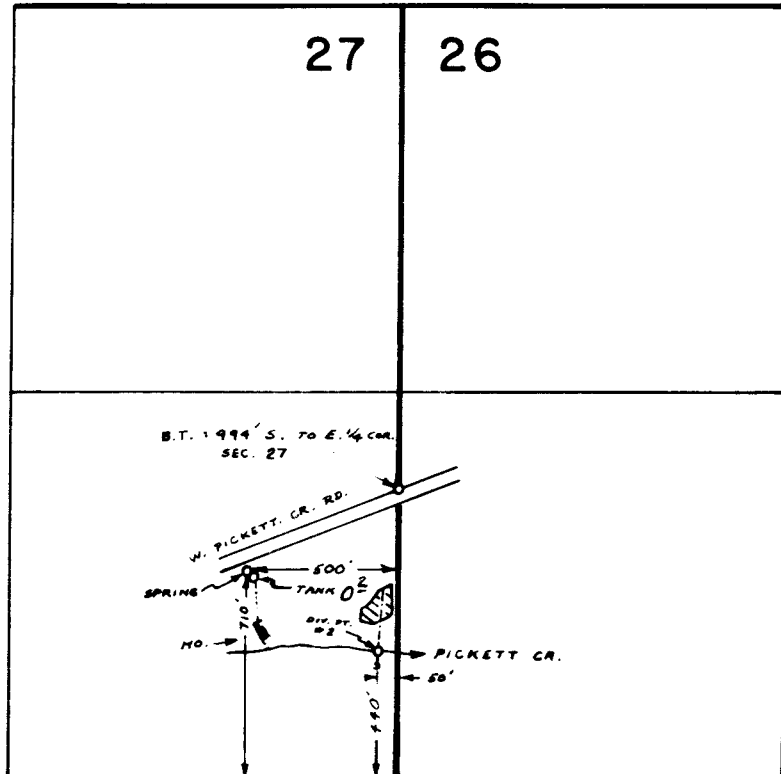

SCALE: 1" = 660 FT.
8" = 1 mile

FINAL PROOF SURVEY
UNDER

Application No. 52775 Permit No. 39842
IN NAME OF

DAVID F. & DIANE E. STOCKTON

Surveyed AUG. 10 1978 by B. SUND

P.T.S. - 1978-14-C