


RECEIVED
MAR 12 1975
STATE ENGINEER
SALEM, OREGON

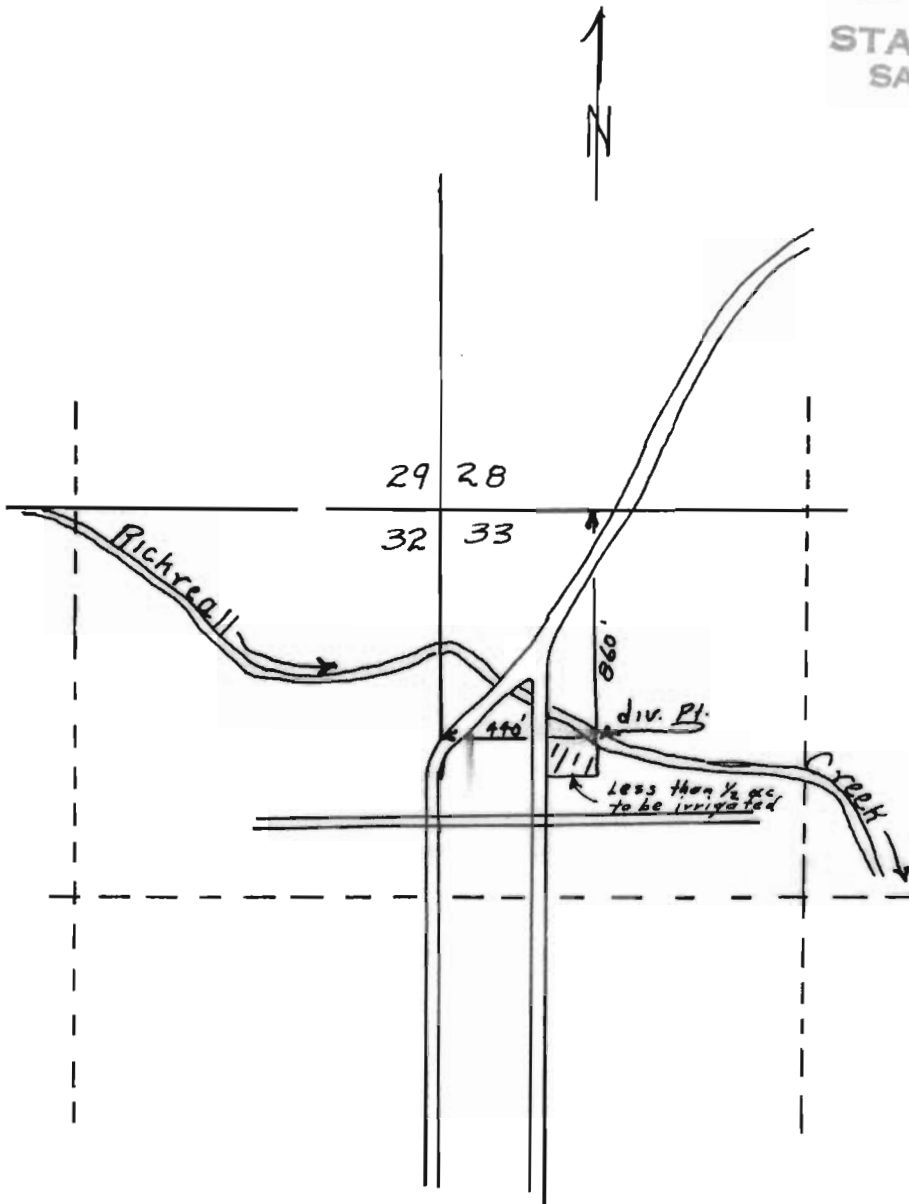

C.M. Barnhart
City of Dallas
Sec 33 T7S R5W
Scale 1" = 660'

Application No. 52843
Permit No. 39889