


Application No. 52343
Permit No. 39891

R5W

R4W

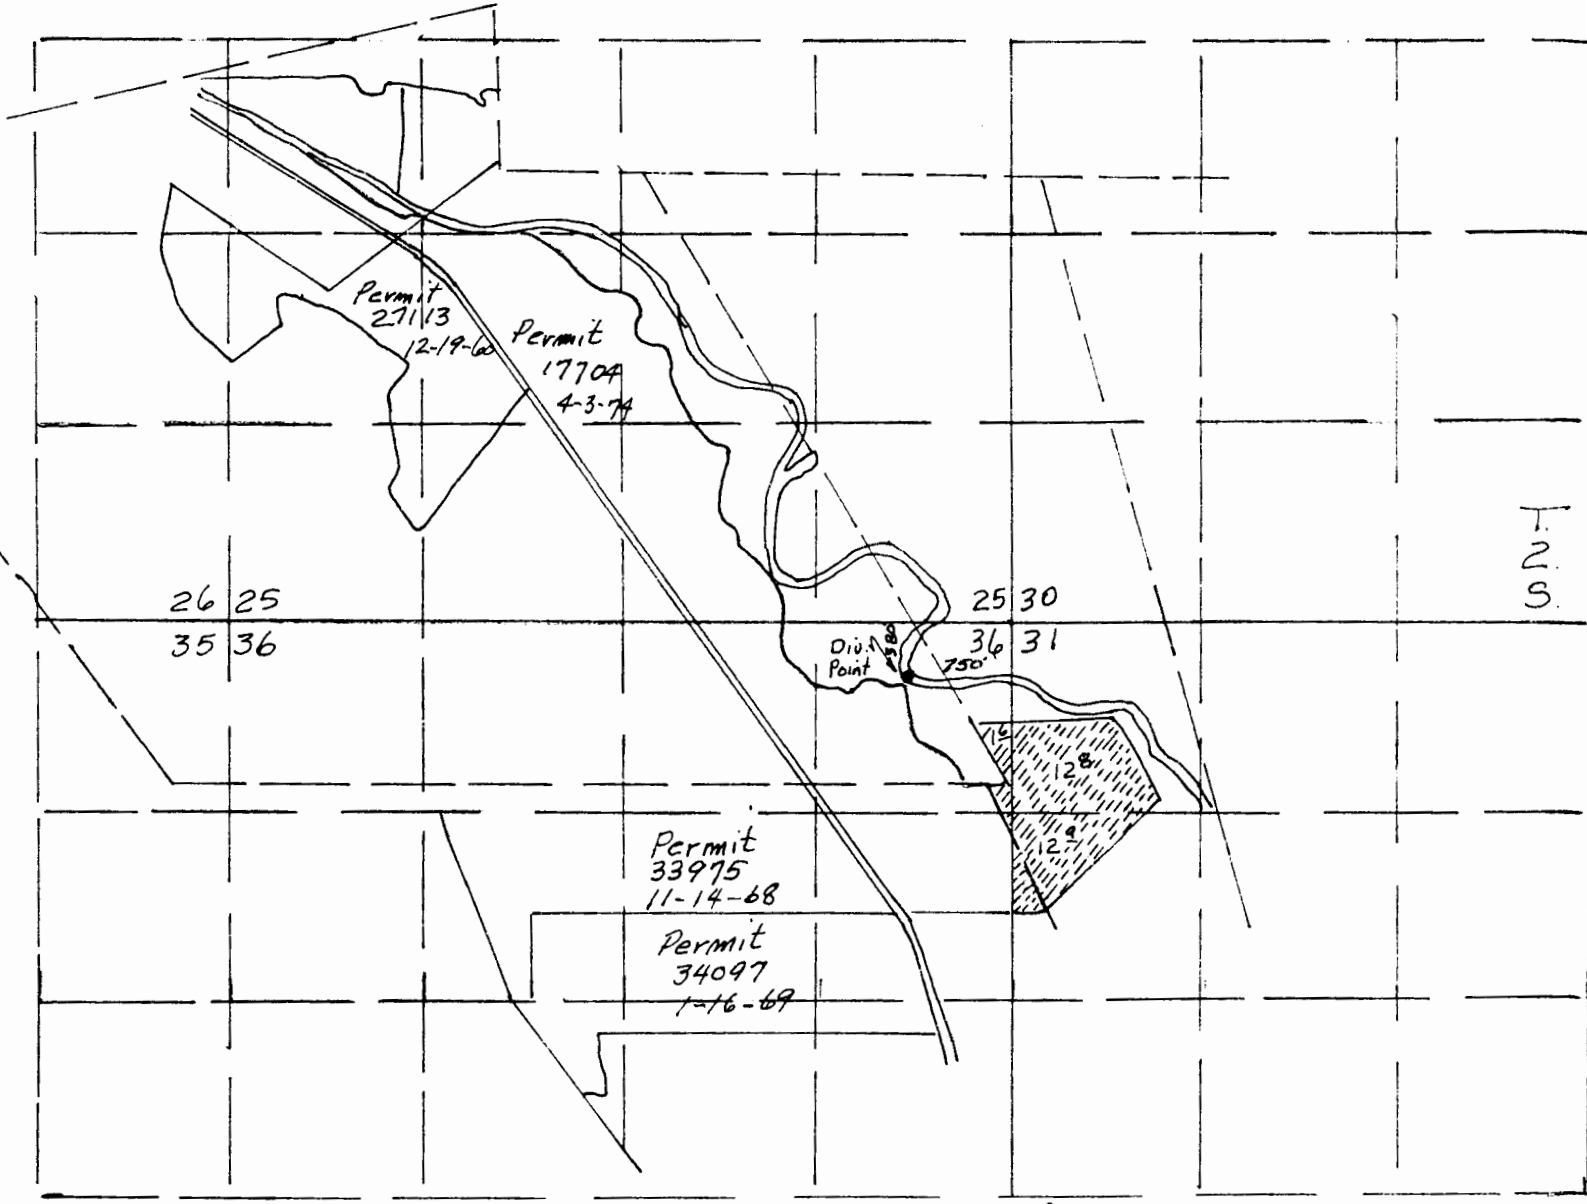

APPLICATION for WATER
HARLEY BELT-YAMHILL Co. SCALE 1" = 1320'