


T.36S.,R.5W.,W.M.

RECEIVED

OCT 8 1980

WM. DIST. 14
GRANTS PASS, ORE.

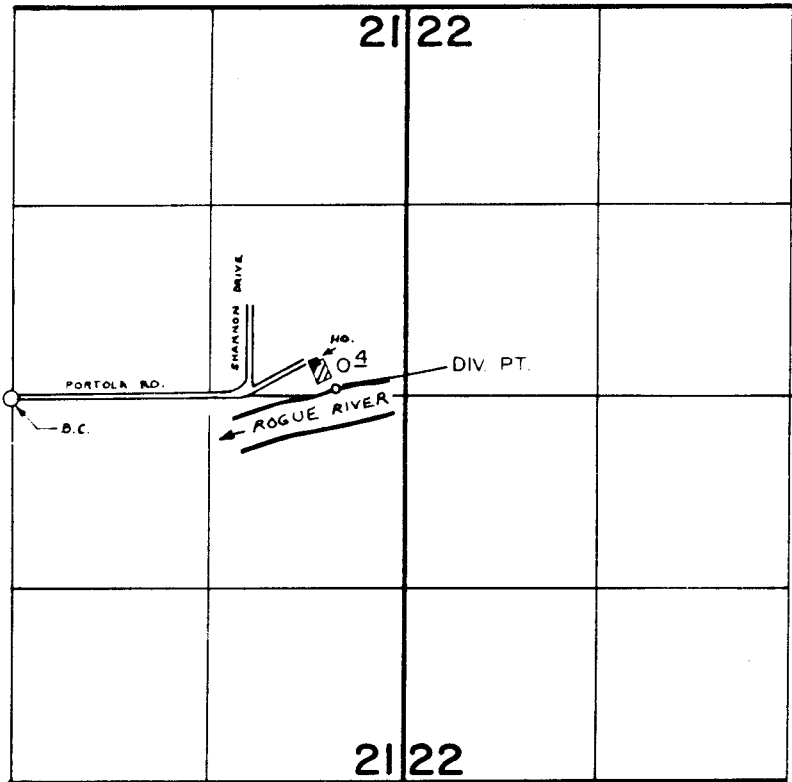

DIV. PT. LOC.: 60' N & 2175' E FROM CENTER SEC. 21

FINAL PROOF SURVEY
UNDER

Cert. 49545

Application No. 52851 Permit No. 39894
IN NAME OF

C.M. & MABELLE H. INMAN

Surveyed OCT. 7 1977, by B. SUND