


RECEIVED

MAR 31 1975
STATE ENGINEER
SALEM, OREGON

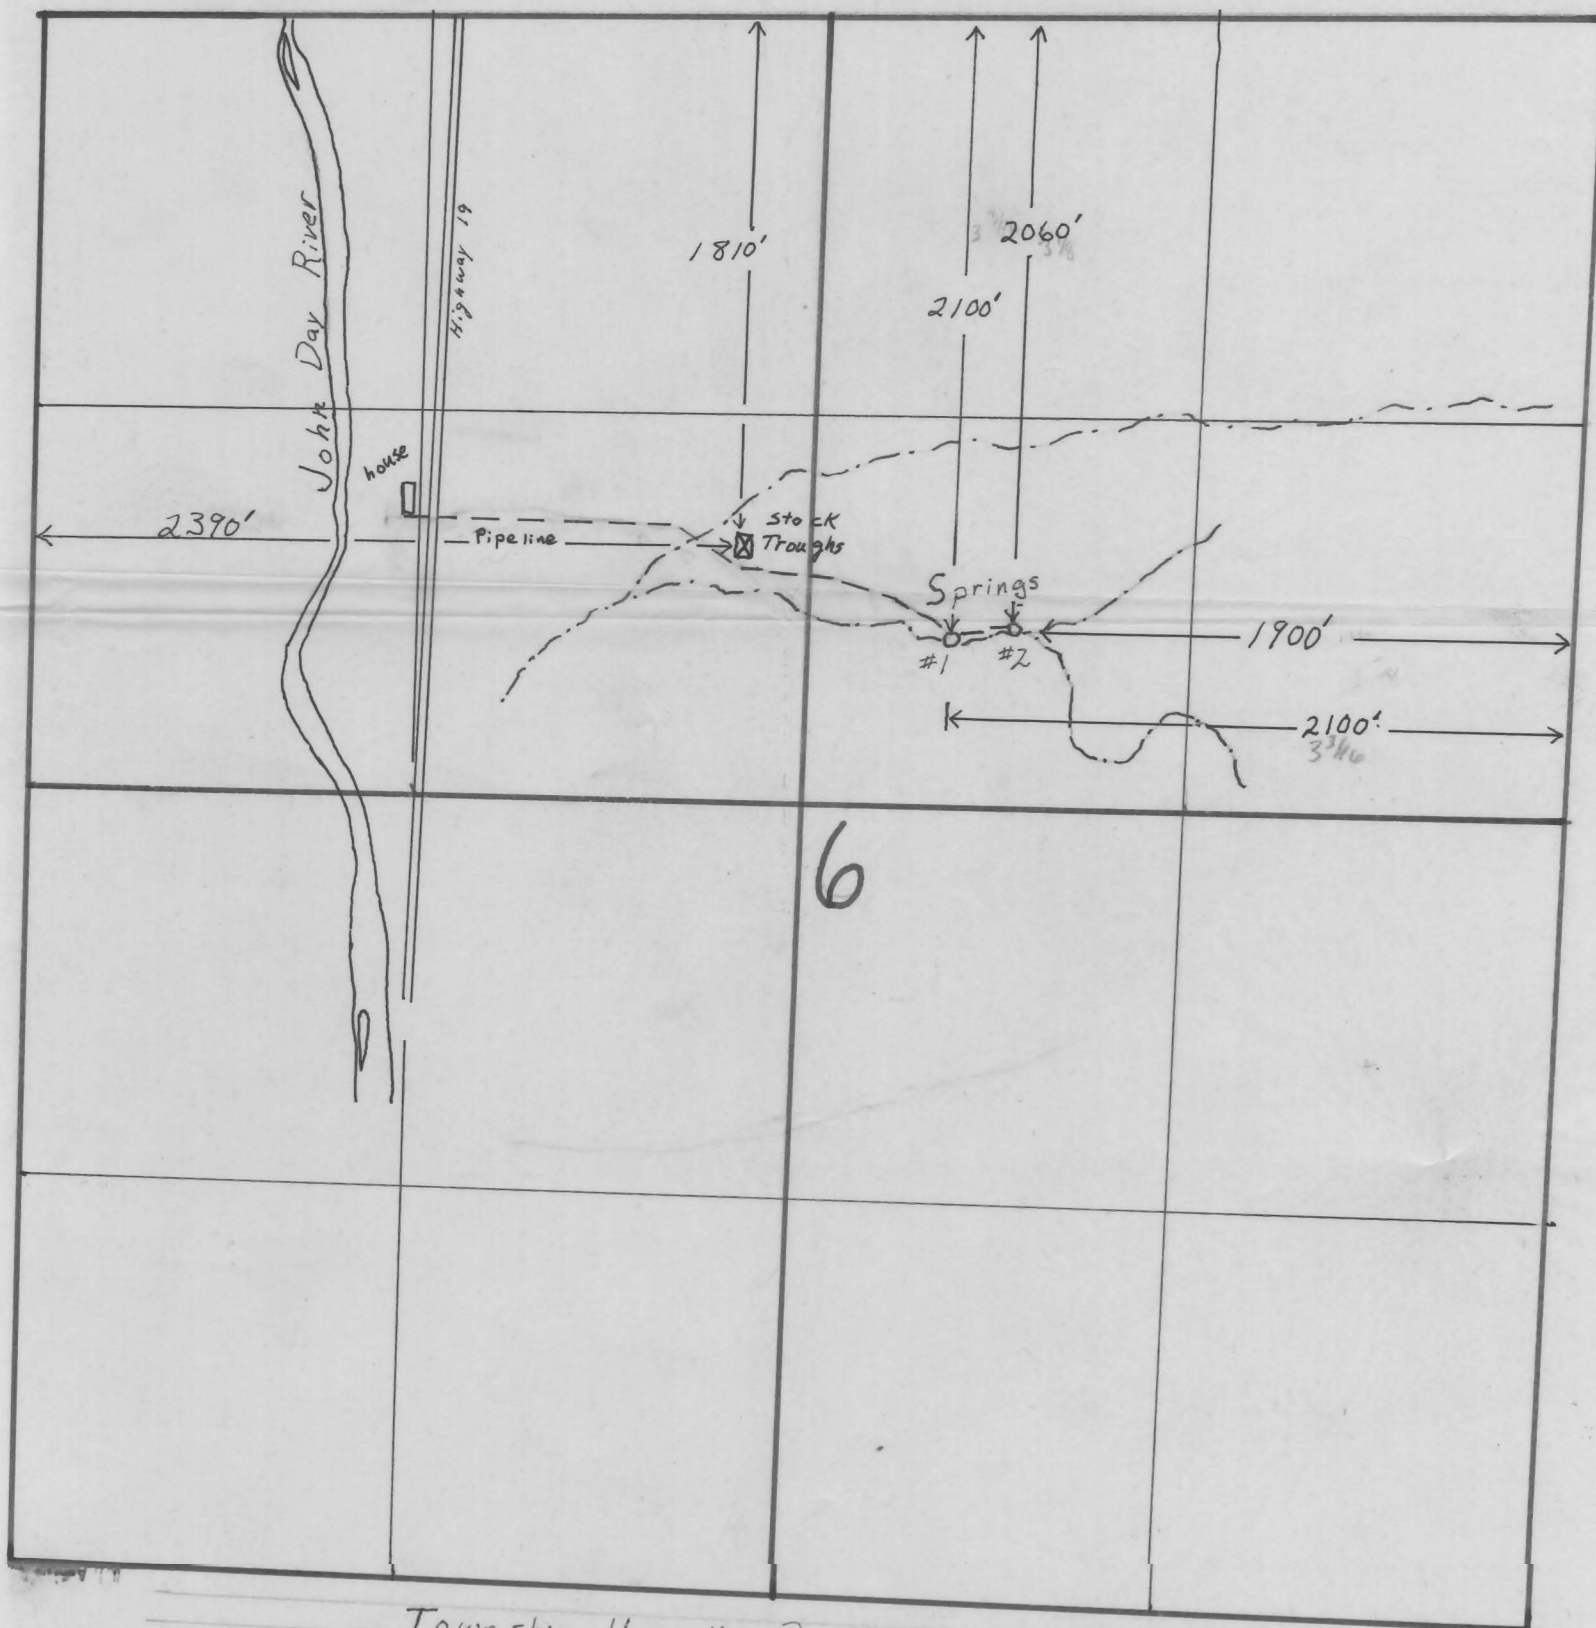

Township 11 south, Range 26 east, section 6

Scale 8" = one mile

Taken from aerial photo

Application for Stock Water

Application No. 52909

Permit No. 39955

11/50 400