J. LOUSIGNONT WATER SYSTEM
CLATSKANIE OREGON — SCALE 400 FT. TO 1 IN.

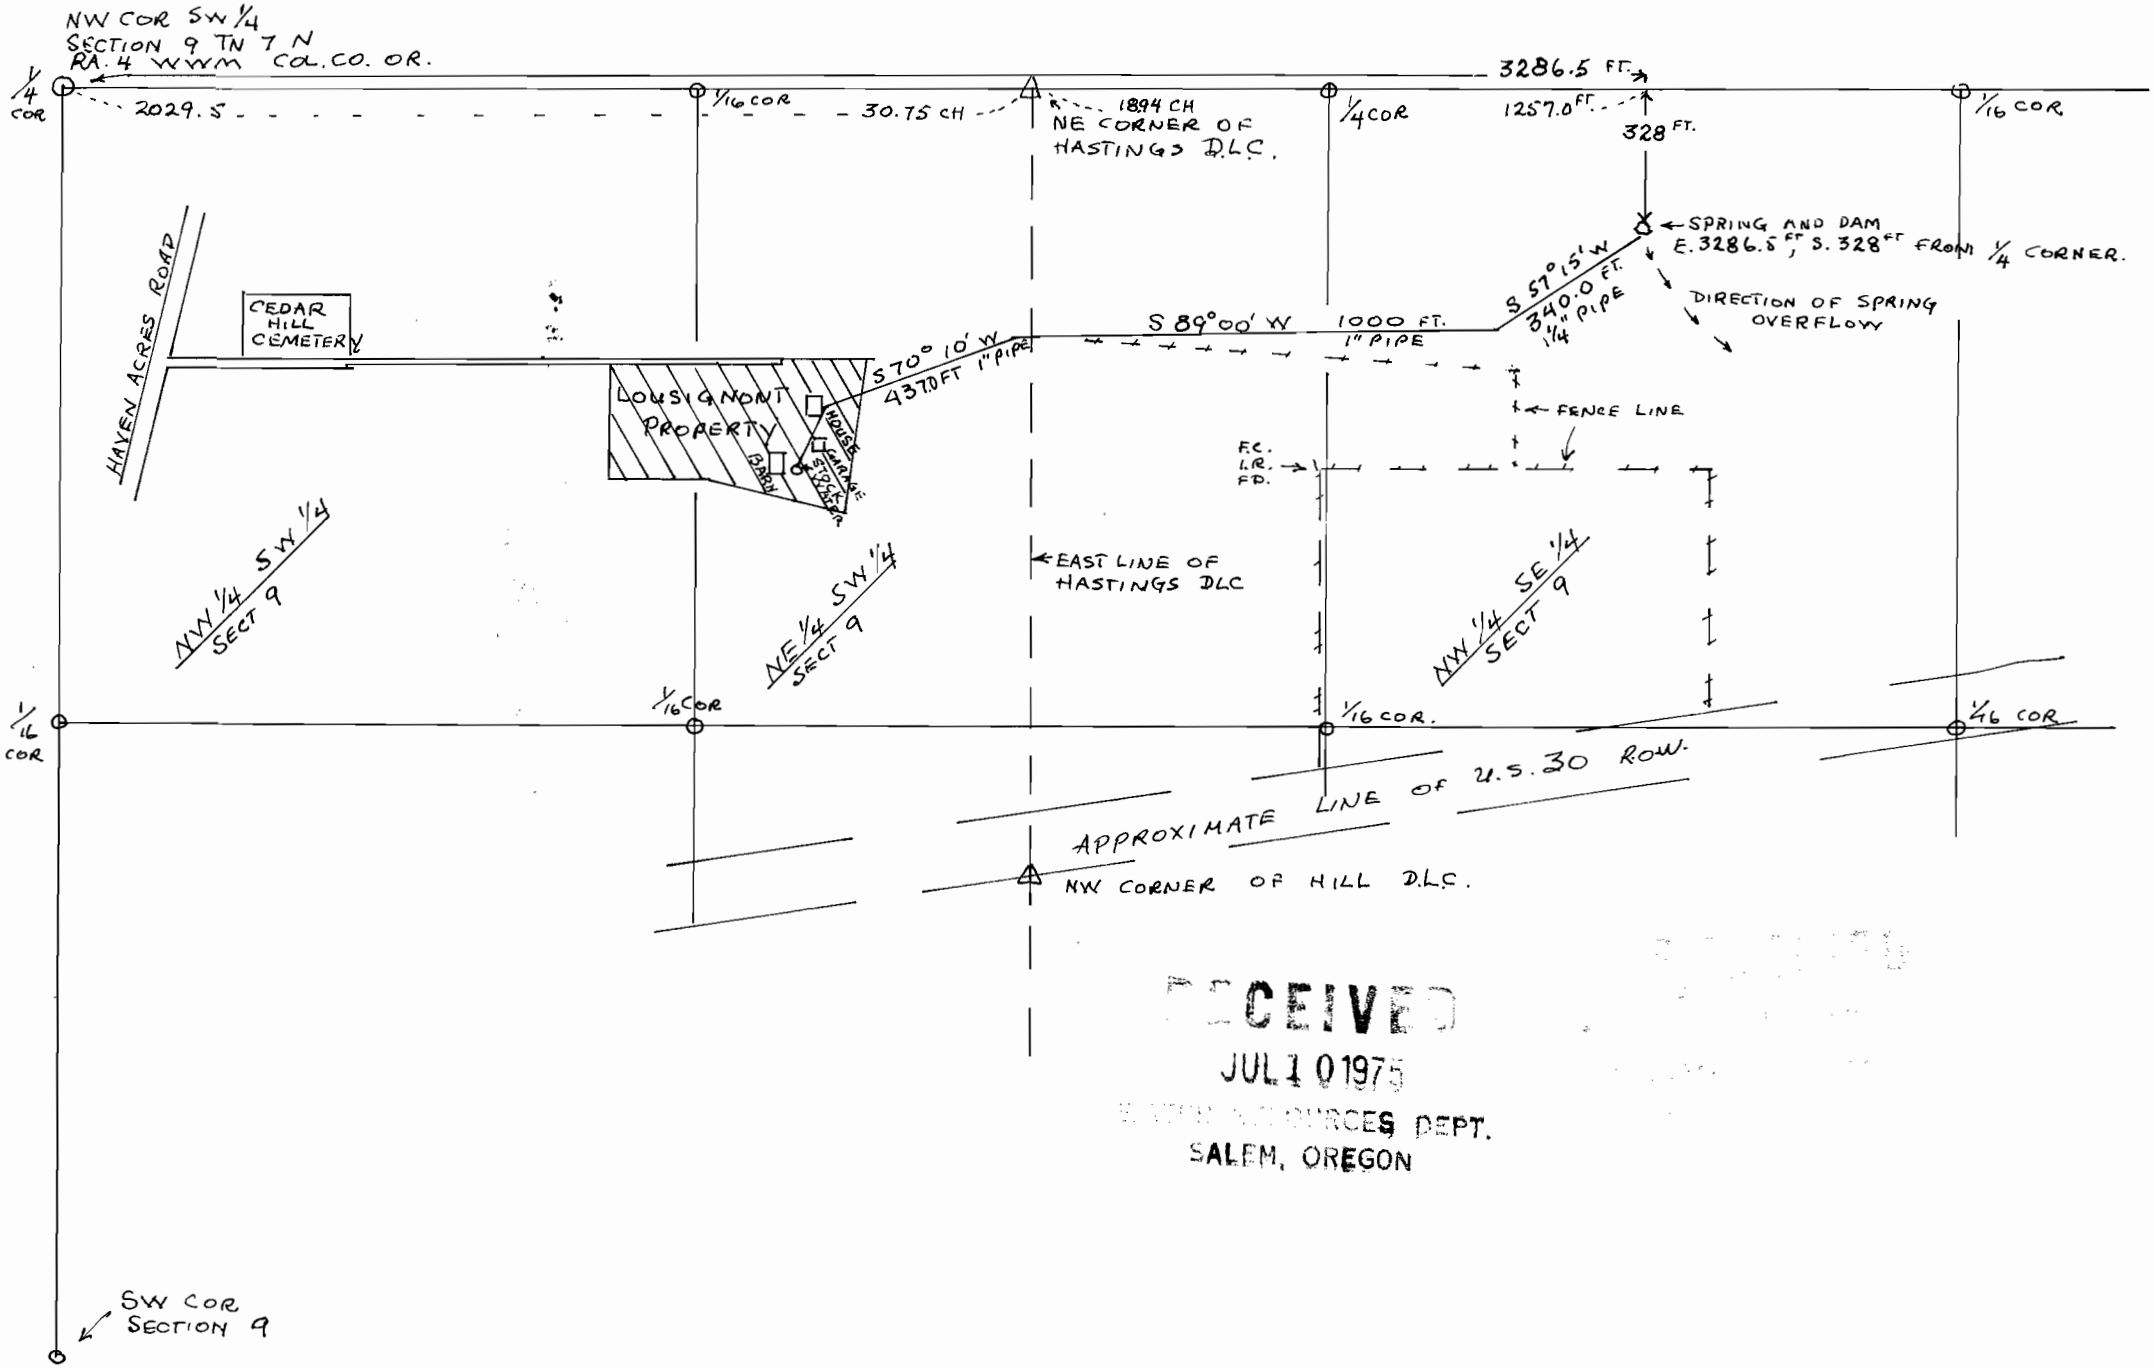

RECEIVED
JUL 1 0 1975
WATER RESOURCES DEPT.
SALEM, OREGON