


T6 SR 3 W WM SEC 33

1" = 660'

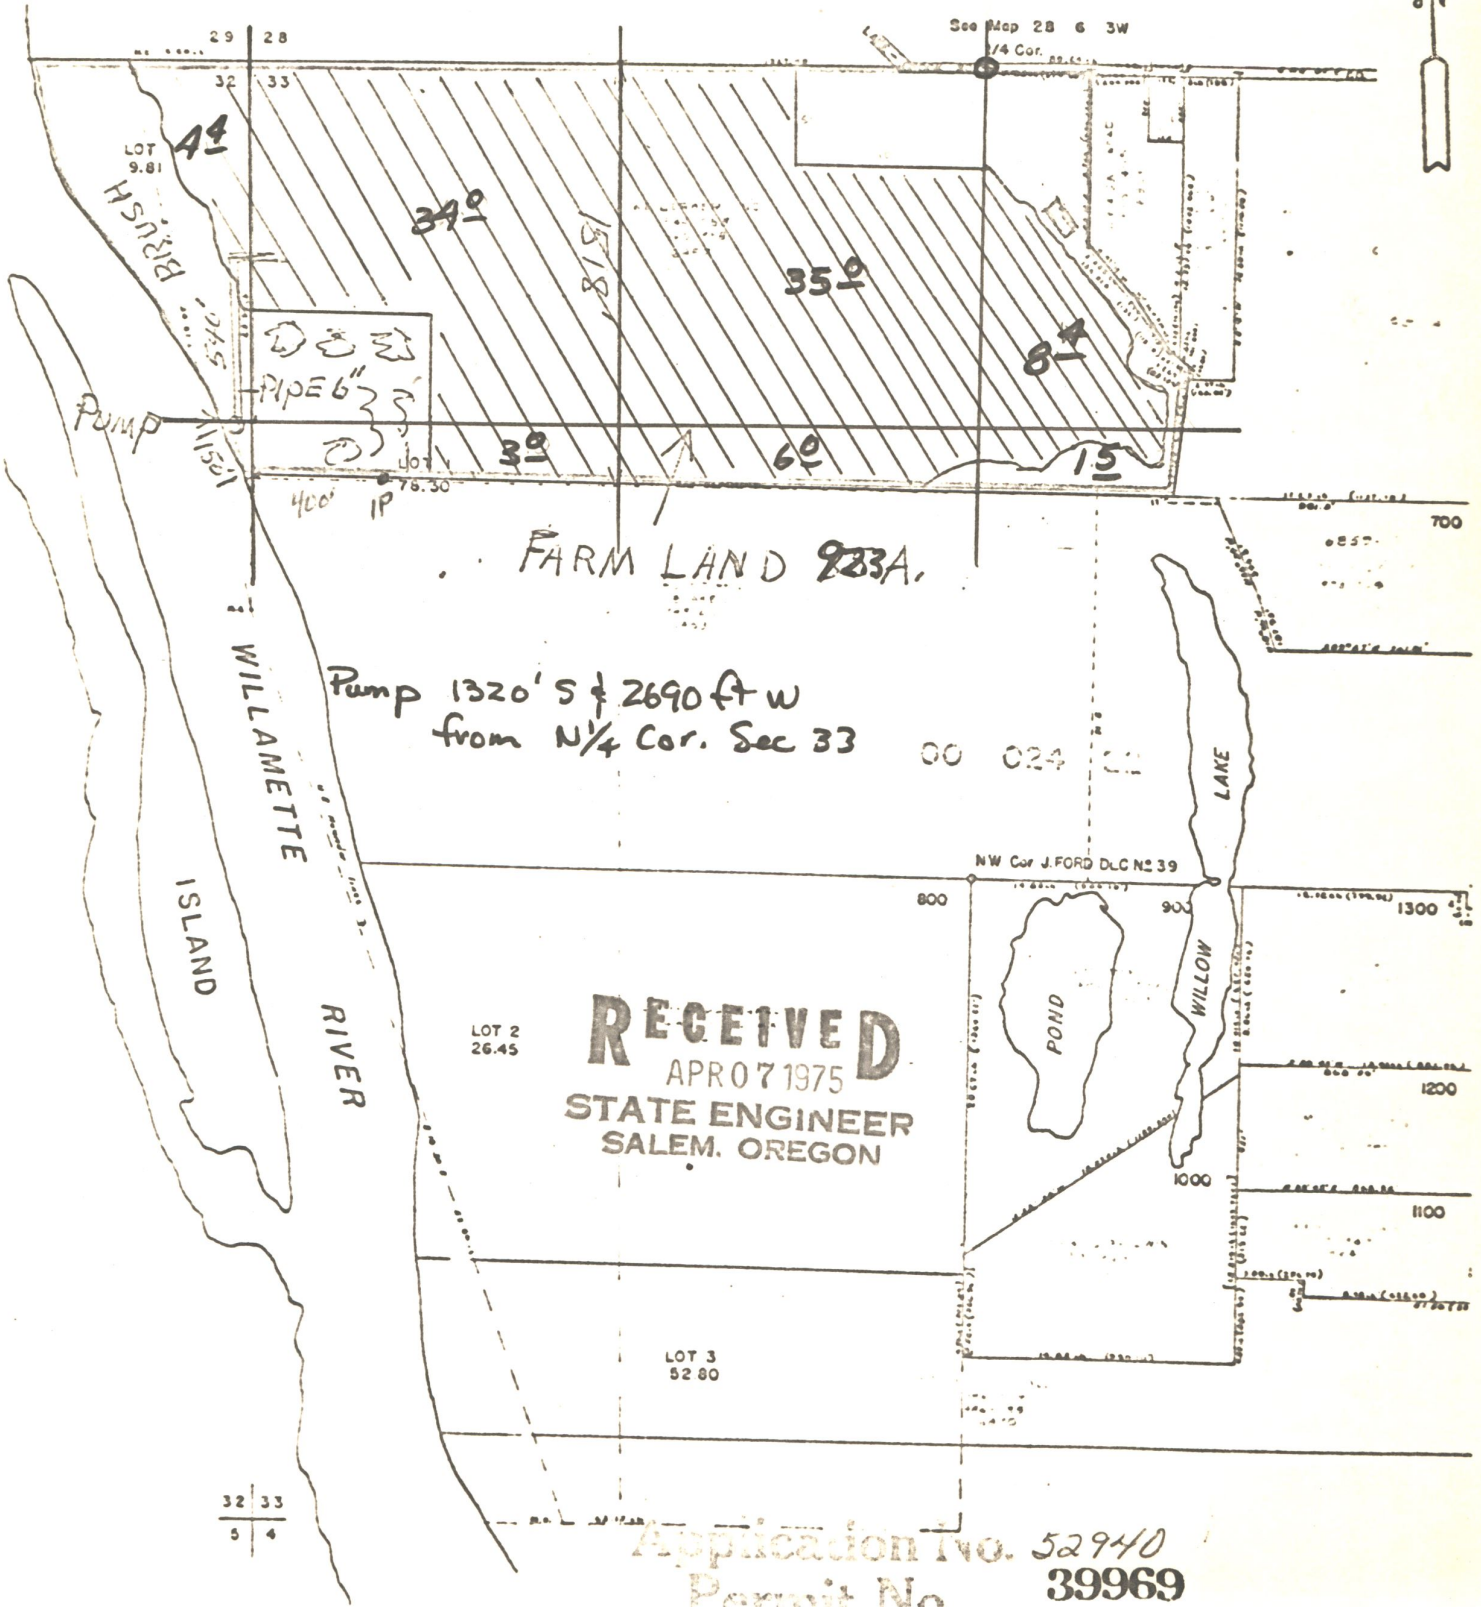

FARM LAND 233A.

Pump 1320' S & 2690' W from N¹/₄ Cor. Sec 33

RECEIVED
APR 07 1975
STATE ENGINEER
SALEM, OREGON

Application No. 52940
Permit No. 39969