


T. 34 S., R. 6 W., W.M.

Sec. 13

NE 1/4 SE 1/4

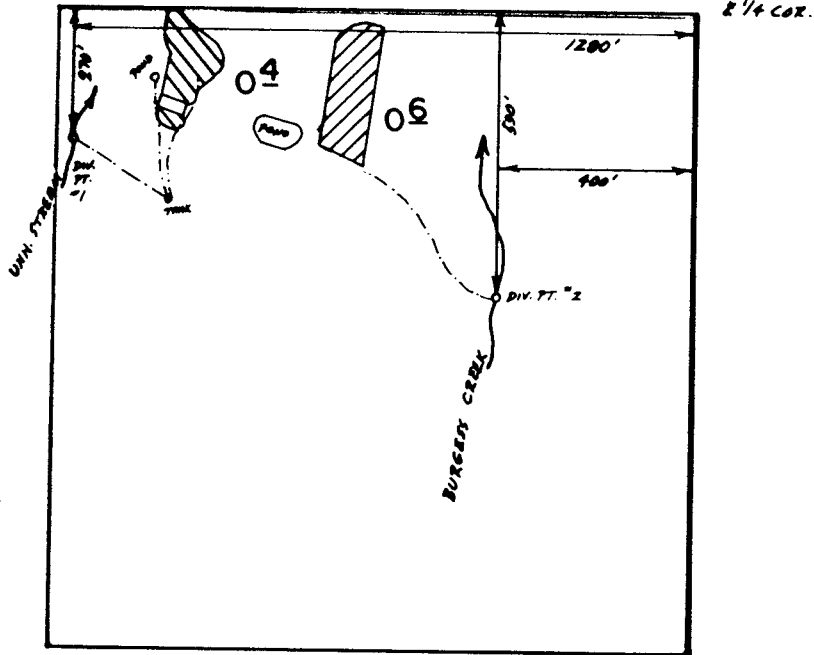

Scale 1" = 400'

RECEIVED

MAR 24 1988

NO. 167. 16-70-57

FINAL PROOF SURVEY
UNDER

Application No. 52969... Permit No. 39987...
IN NAME OF

.....DARIO A. SCARABOSIO.....

Surveyed Sept. 18, 1984, by J.R. WOODROOF