


T.35S., R.3W., W.M.

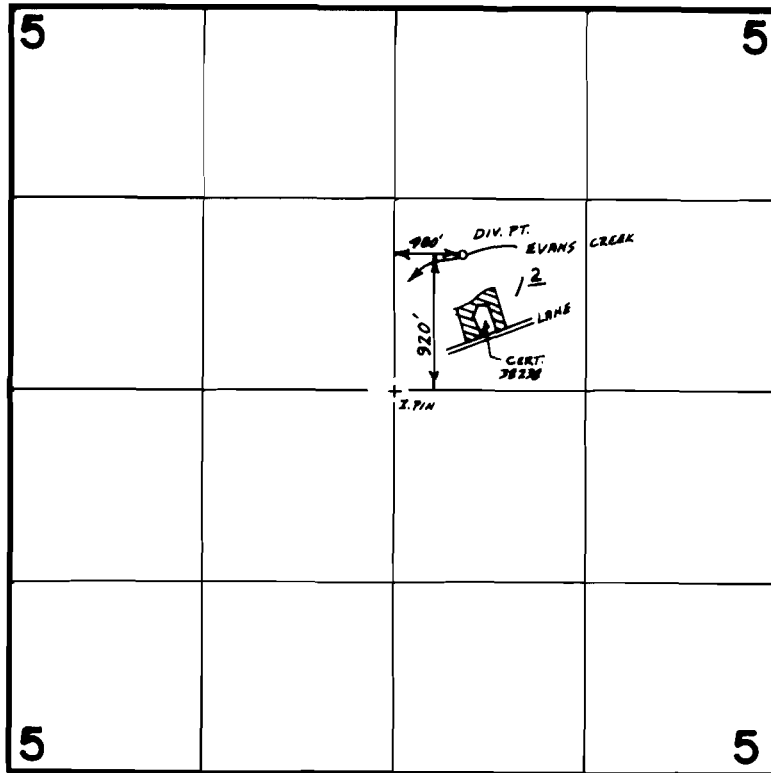

SCALE 1"=1320'

**FINAL PROOF SURVEY**  
UNDER

Application No. 53005 Permit No. 40009.....  
IN NAME OF

WALTER E. ZAHLMANN.....

Surveyed Nov. 13, 1984, by J.R. WOODROOF