

NE 1/4 Sec. 4 & NW 1/4 Sec. 3 T18S R11W W.M.

LOT 4 Sec. 3

Point of diversion

LOT 1 Sec. 4

Domestic use


RECEIVED

APR 28 1975

STATE ENGINEER

DAVIDSON

SCALE 1" = 400'

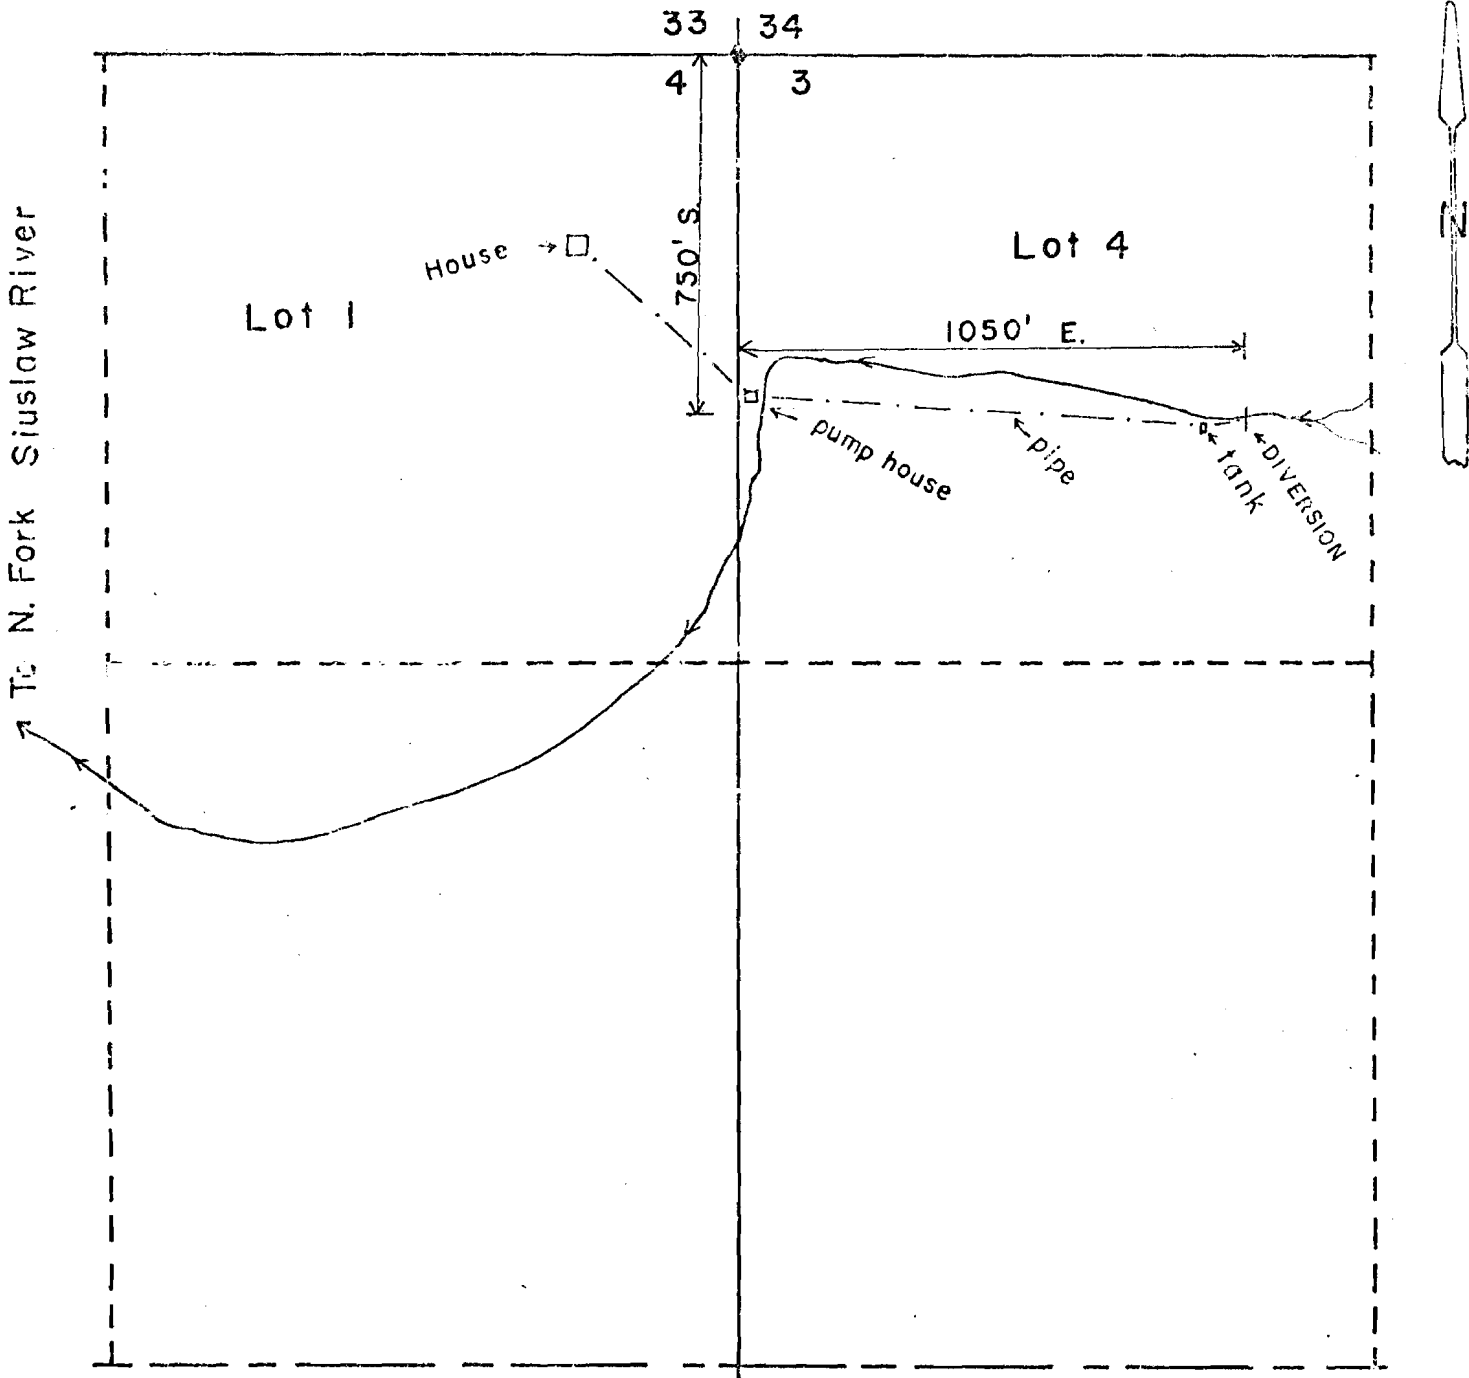

DAVIDSON IND., INC.

Permit No. 53053
40036