


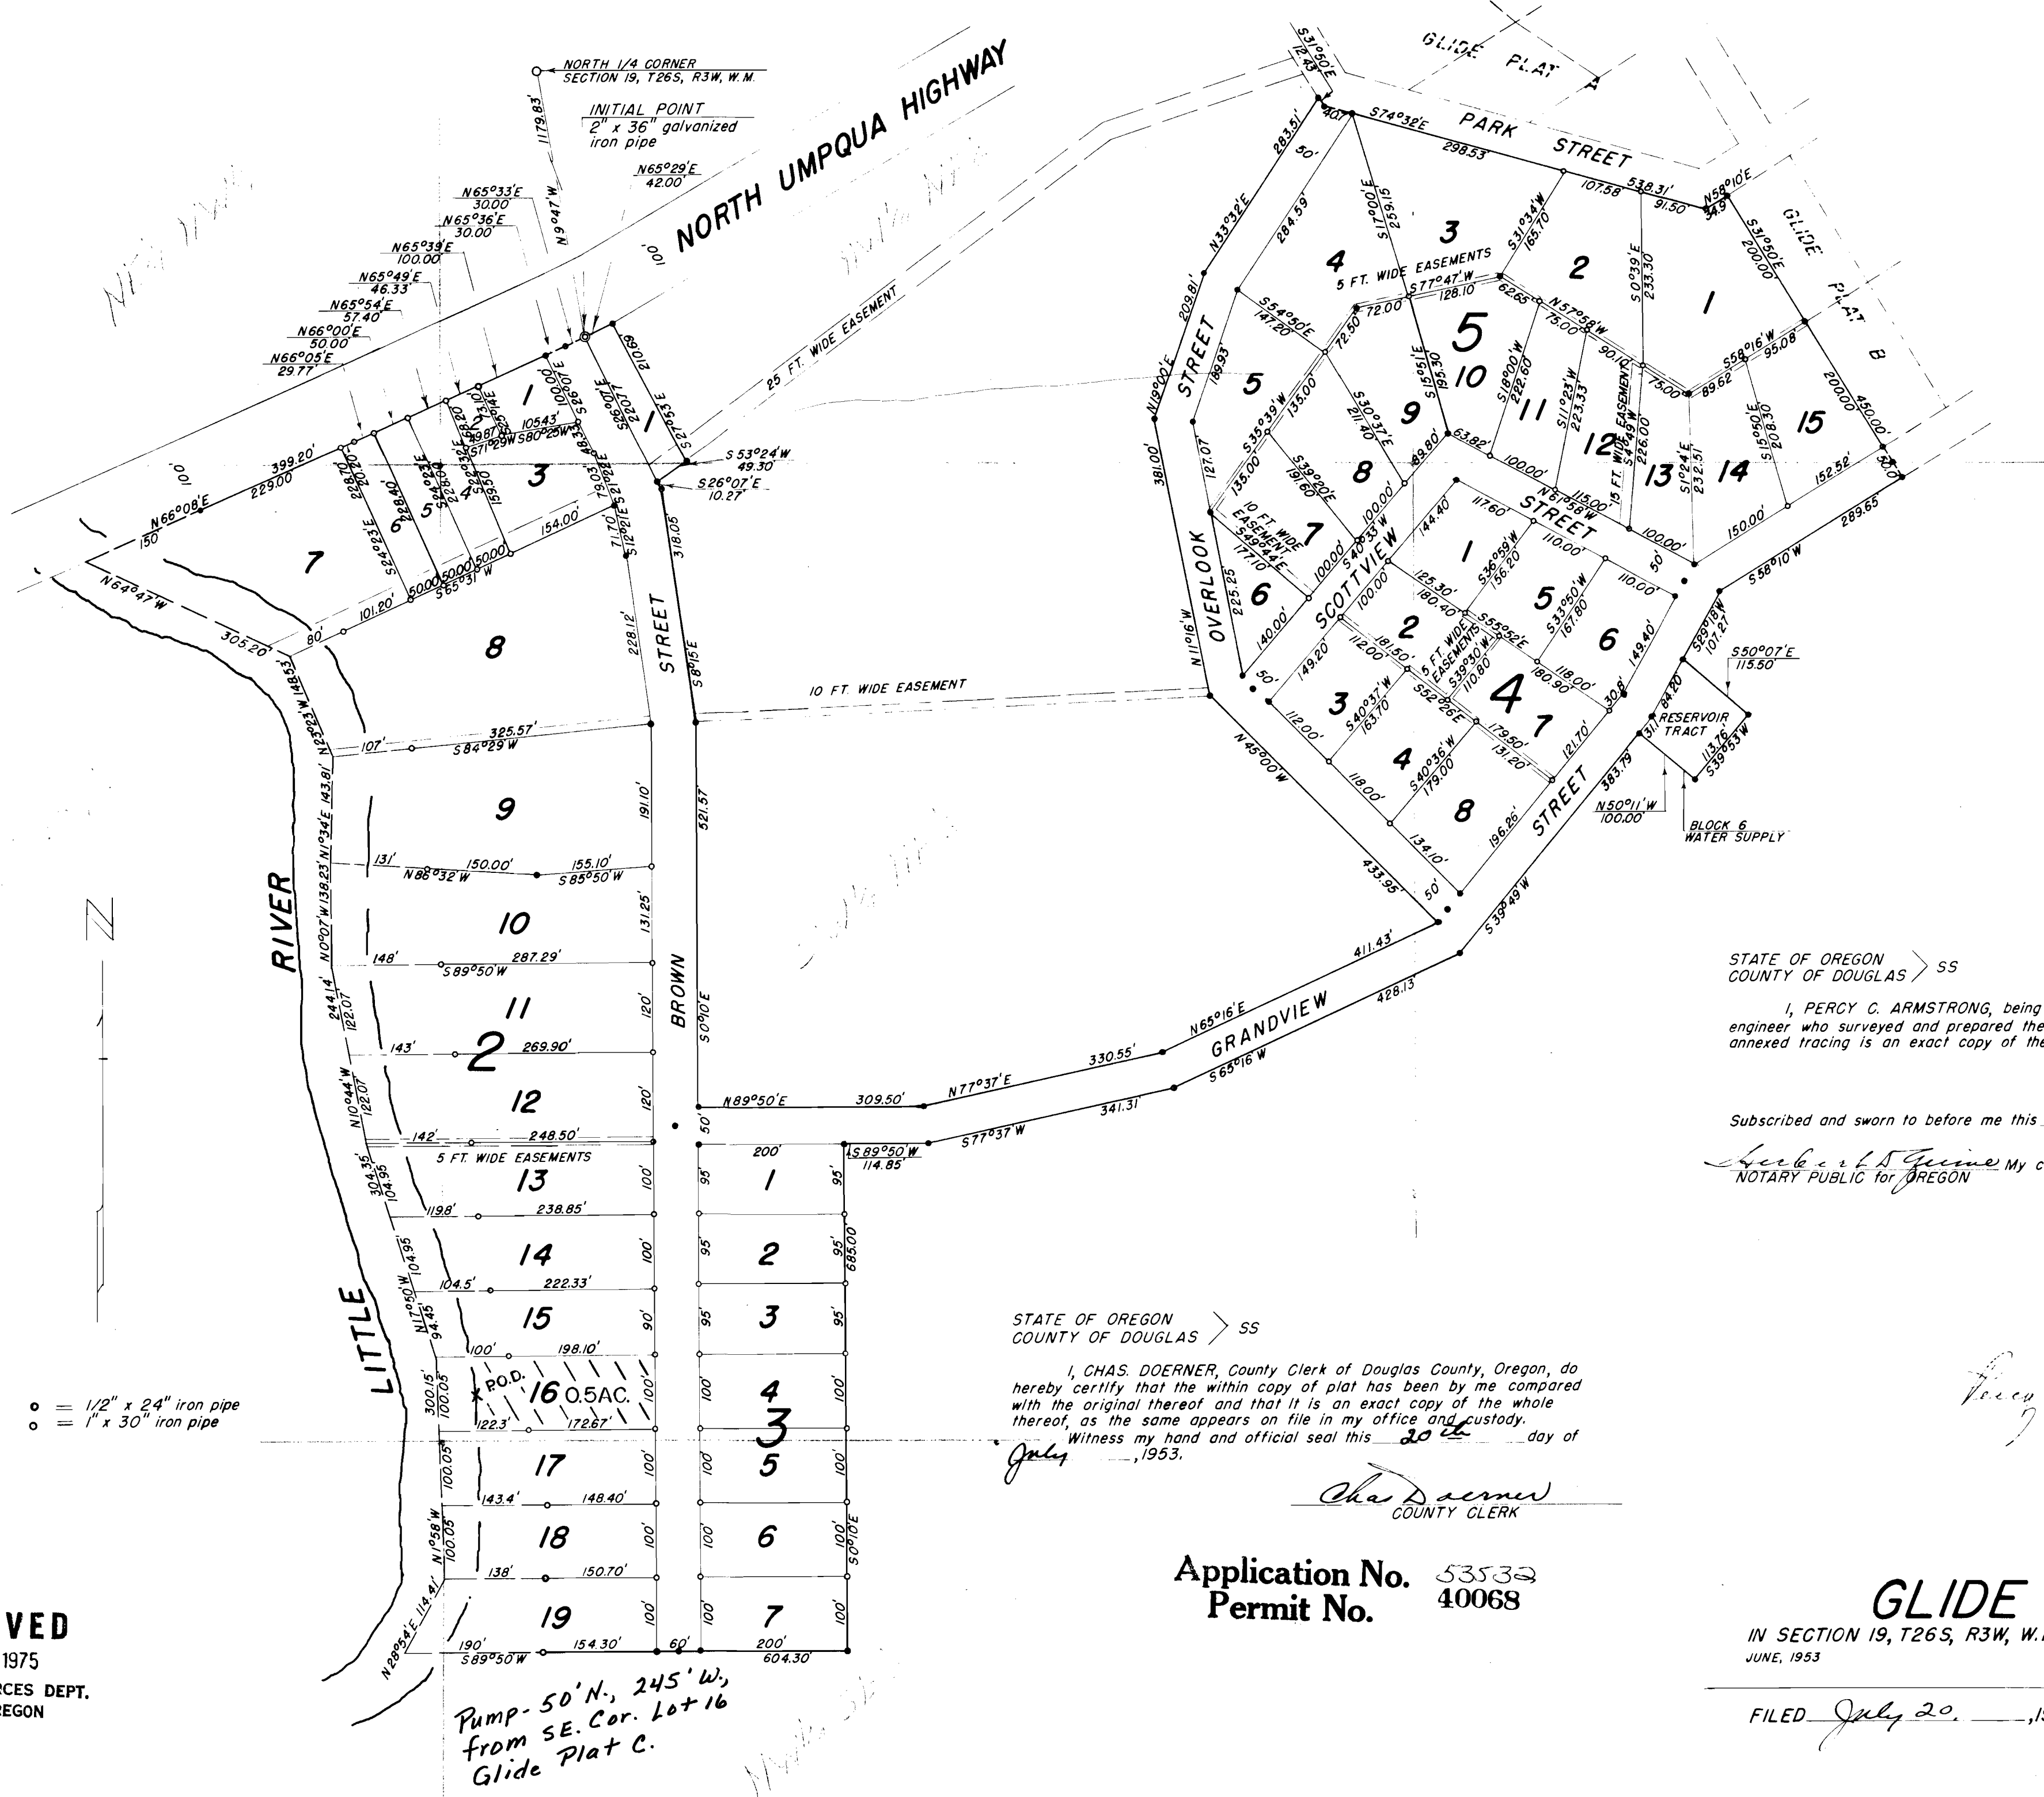

STATE OF OREGON > SS
COUNTY OF DOUGLAS

I, PERCY C. ARMSTRONG, being duly sworn, depose and say that I am the engineer who surveyed and prepared the plat of "GLIDE PLAT C" and that the annexed tracing is an exact copy of the final plat thereof.

Subscribed and sworn to before me this 8 day of July, 1953.

Herbert S. Guine My commission expires Feb. 20, 1955.
NOTARY PUBLIC for OREGON

STATE OF OREGON > SS
COUNTY OF DOUGLAS

I, CHAS. DOERNER, County Clerk of Douglas County, Oregon, do hereby certify that the within copy of plat has been by me compared with the original thereof and that it is an exact copy of the whole thereof, as the same appears on file in my office and custody.

Witness my hand and official seal this 20th day of July, 1953.

Chas Doerner
COUNTY CLERK

Application No. 53532
Permit No. 40068

GLIDE PLAT C

IN SECTION 19, T26S, R3W, W.M., DOUGLAS COUNTY, OREGON
JUNE, 1953 SCALE: 1" = 150'

FILED July 20, 1953 *Chas Doerner*
COUNTY CLERK

RECEIVED

AUG 13 1975

WATER RESOURCES DEPT.
SALEM, OREGON

RECEIVED

SEP 24 1975

WATER RESOURCES DEPT.
SALEM, OREGON